MAP FILE M154-70

NARRATIVE:
THE PURPOSE OF THIS SURVEY WAS TO RE-MONUMENT THE BOUNDARY OF PARCEL 2, AS PLATTED AND RECORDED IN FINAL LAND PARTITION PLAT 1995-0010 AND AS CALLED FOR IN DOCUMENT NO. 2007-014152, DOUGLAS COUNTY OFFICIAL RECORDS. MONUMENTS FOUND FOR THE NORTHWEST CORNER AND ON THE SOUTH LINE OF PARCEL 1 TOGETHER WITH THE MONUMENTS FOUND ON THE NORTHWESTERLY LINE OF PARCEL 2 FIT WELL WITH RECORD PLAT DATA. THESE MONUMENTS WERE HELD FOR ORIENTATION AND MISSING CORNERS FOR PARCEL 2 WERE RE-ESTABLISHED AT RECORD PLAT POSITION.

FILED
Date: 12/31/2007 By: JC
This survey consists of:
Map: M154-70
Narrative:
Corner Rpt:
DOUGLAS COUNTY SURVEYOR

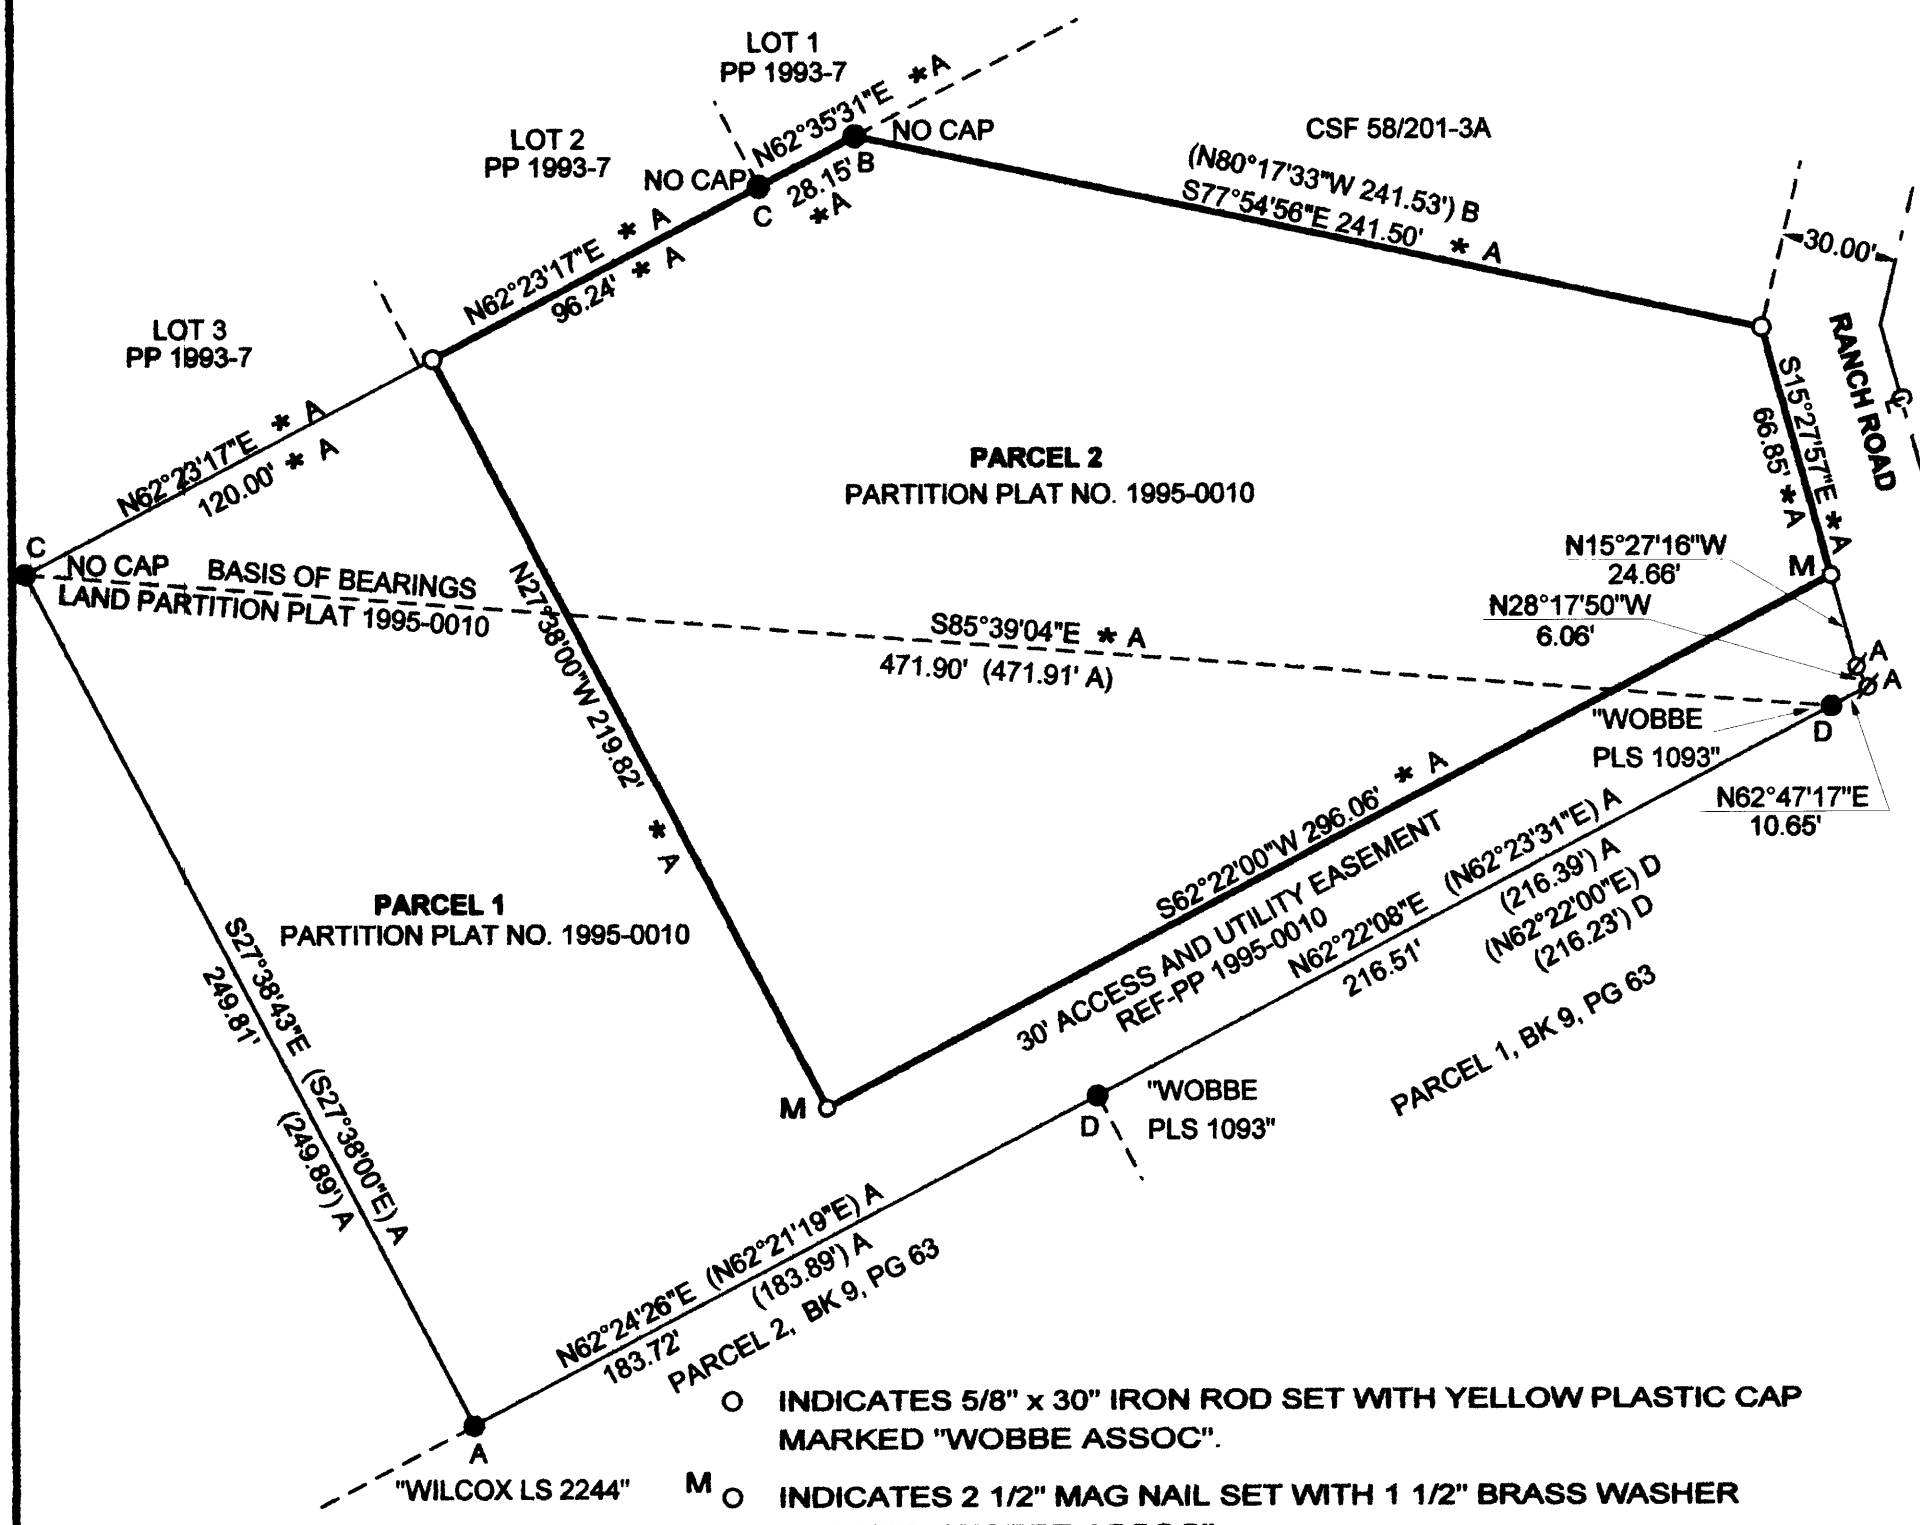

O INDICATES 5/8" x 30" IRON ROD SET WITH YELLOW PLASTIC CAP MARKED "WOBBE ASSOC".

M O INDICATES 2 1/2" MAG NAIL SET WITH 1 1/2" BRASS WASHER MARKED "WOBBE ASSOC".

● INDICATES 5/8" IRON ROD FOUND WITH YELLOW PLASTIC CAP MARKED AS INDICATED.

* INDICATES MEASURED DATA SAME AS RECORD.

( ) INDICATES RECORD DATA

EQUIPMENT USED: NIKON DTM - 522

ø INDICATES A COMPUTED POINT

SURVEY REFERENCES:
A - LAND PARTITION PLAT 1995-0010
B - CSF 58/201-3A
C - LAND PARTITION PLAT 1993-0007
D - PARTITION MAP BOOK 9 PAGE 63

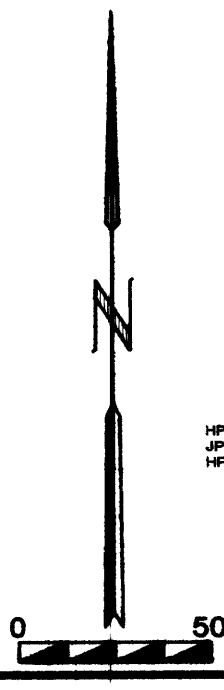

HP DESIGNJET 500
JPC-4M2
HP C4844A

22-12-4-B-A TL 1501
22-12-4-2-1 TL 1501

JOB F0728

REGISTERED PROFESSIONAL LAND SURVEYOR
Eugene M. Wobbe
OREGON
JULY 30, 1976
EUGENE M. WOBBE
1093
P.L.S. EXPIRATION DATE: 6-30-2008
G:\DC\D2007\0728 REEDSPORT.DWG

WOBBE & ASSOCIATES, INC.
510 KINGWOOD ST./ P.O. BOX 3093
FLORENCE, OR 97439

SURVEY FOR:
DON LAMB
NW 1/4, SEC. 4, T22S, R12W, W.M.
DOUGLAS COUNTY, OREGON
NOVEMBER 9, 2007 | DRAWN: PE - AM

MAP FILE M154-70