RECORD OF SURVEY

LOCATED IN
SECTION 12, T.32S., R.4W., W.M.
DOUGLAS COUNTY, OREGON

FILED
Date: 5/7/2008 By: JP
This survey consists of:
Map: M 155-59
Narrative: _____
Corner Rpt: _____
DOUGLAS COUNTY
SURVEYOR

MAP FILE M155-59

NARRATIVE:

THE PURPOSE OF THIS SURVEY IS TO POST, BLAZE, AND PAINT THE NORTH LINE OF SECTION 12 AS SHOWN OF THE FACE OF THIS MAP. THE NORTHEAST CORNER OF SECTION 12 AND THE SOUTHWEST CORNER OF SECTION 1 ARE USGLO CORNERS PERPETUATED IN THEIR ORIGINAL CORNER POSITIONS. THE SOUTH 1/4 CORNER OF SECTION 1 ONLY WAS ESTABLISHED BY NYGREN IN 1996 PER M 124-34. THE NORTH LINE OF SECTION 12 WAS MARKED BETWEEN THESE CONTROLLING MONUMENTS. THE LINE BETWEEN THE SOUTHWEST CORNER OF SECTION 1 AND THE CLOSING CORNER OF SECTION 11 AND 12 WAS FOUND BLAZED UNDER OTHERS.

A CONTROL SURVEY WAS PERFORMED UTILIZING A STATIC GPS CONTROL SURVEY WITH RTK AND CONVENTIONAL TRAVERSE LOOPS AND TIES SURVEYED TO CONTROLLING CORNERS AND ALONG BOUNDARY LINES POSTED. ALL SURVEY OBSERVATIONS WERE TAKEN WITH A LEICA TCRP 1203 TOTAL STATION AND LEICA SYSTEMS 1200 GPS RECEIVERS AND WERE ADJUSTED BY LEAST SQUARES METHODS. THIS SURVEY WAS PERFORMED BY LESTER FANNING, ADAM DEGROOT, RICK SANFORD, AND JOEL HERZBERG USING A LEICA 1200 SYSTEMS TOTAL STATION WITH COMPUTATIONS AND DRAFTING BY KRIS DEGROOT AND JOEL HERZBERG.

LEGEND:

- ◓ = FOUND BRASS CAP AS NOTED
- ● = FOUND 5/8" IRON ROD PER M 124-34
- —FL—FL— = PROPERTY LINES BLAZED, PAINTED & POSTED WITH 5 1/2' STEEL POSTS
- ( ) = RECORD PER M 124-34
- [ ] = RECORD PER 1898 USGLO SURVEY

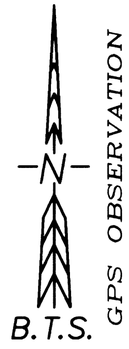

REGISTERED
PROFESSIONAL
LAND SURVEYOR
Kristian O. DeGroot
OREGON
JULY 17, 1981
KRISTIAN O. DEGROOT
1941
RENEWAL DATE: 12-31-09

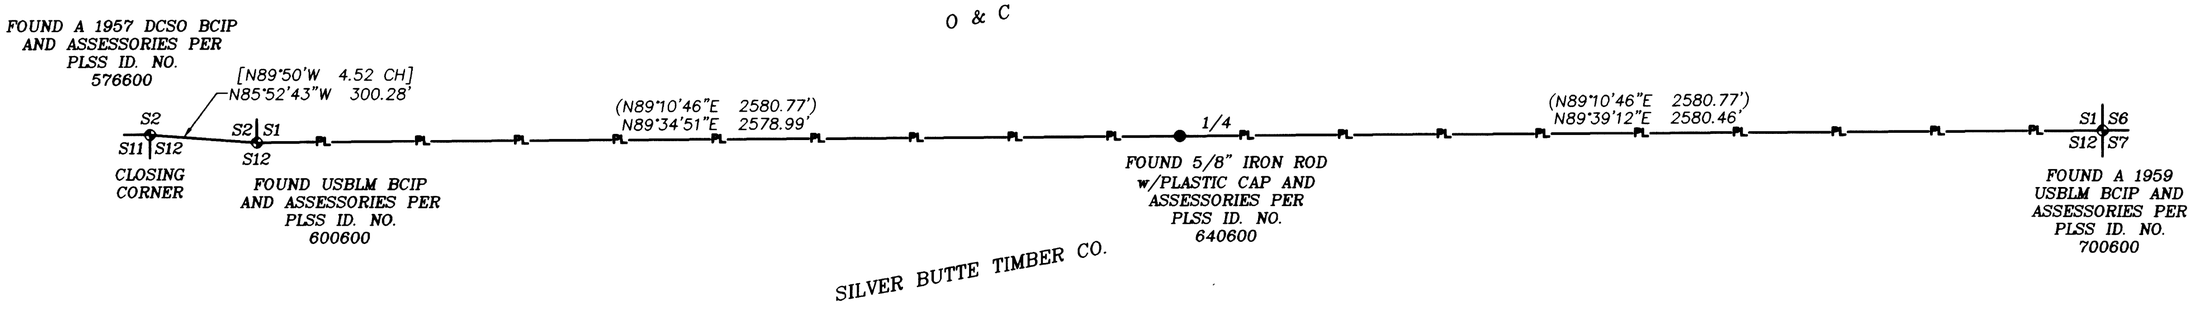

BTS ENGINEERING & SURVEYING, INC.
431 S.E. MAIN ST., ROSEBURG, OR 97470
PHONE (541) 673-0966 FAX (541) 673-0105

SCALE: 1" = 300'	FOR: SILVER BUTTE TIMBER CO. P.O. BOX 4 RIDDLE, OR 97469	JOB #: 07-072
DATE: MAY 7, 2008		FILE: 07-072 SB Section 12.DWG
		SHEET 1 OF 1

MAP FILE M155-59