MAP OF SURVEY

LOCATED in Section 22, T. 32 S., R. 4 W., W.M., Douglas Co., OR.

November 8, 2010

FILED
Date: 12-16-2010 By: JC
This survey consists of
Map: M 161-51
Narrative:
Corner Rpt:
DOUGLAS COUNTY SURVEYOR

MAP FILE M161-51

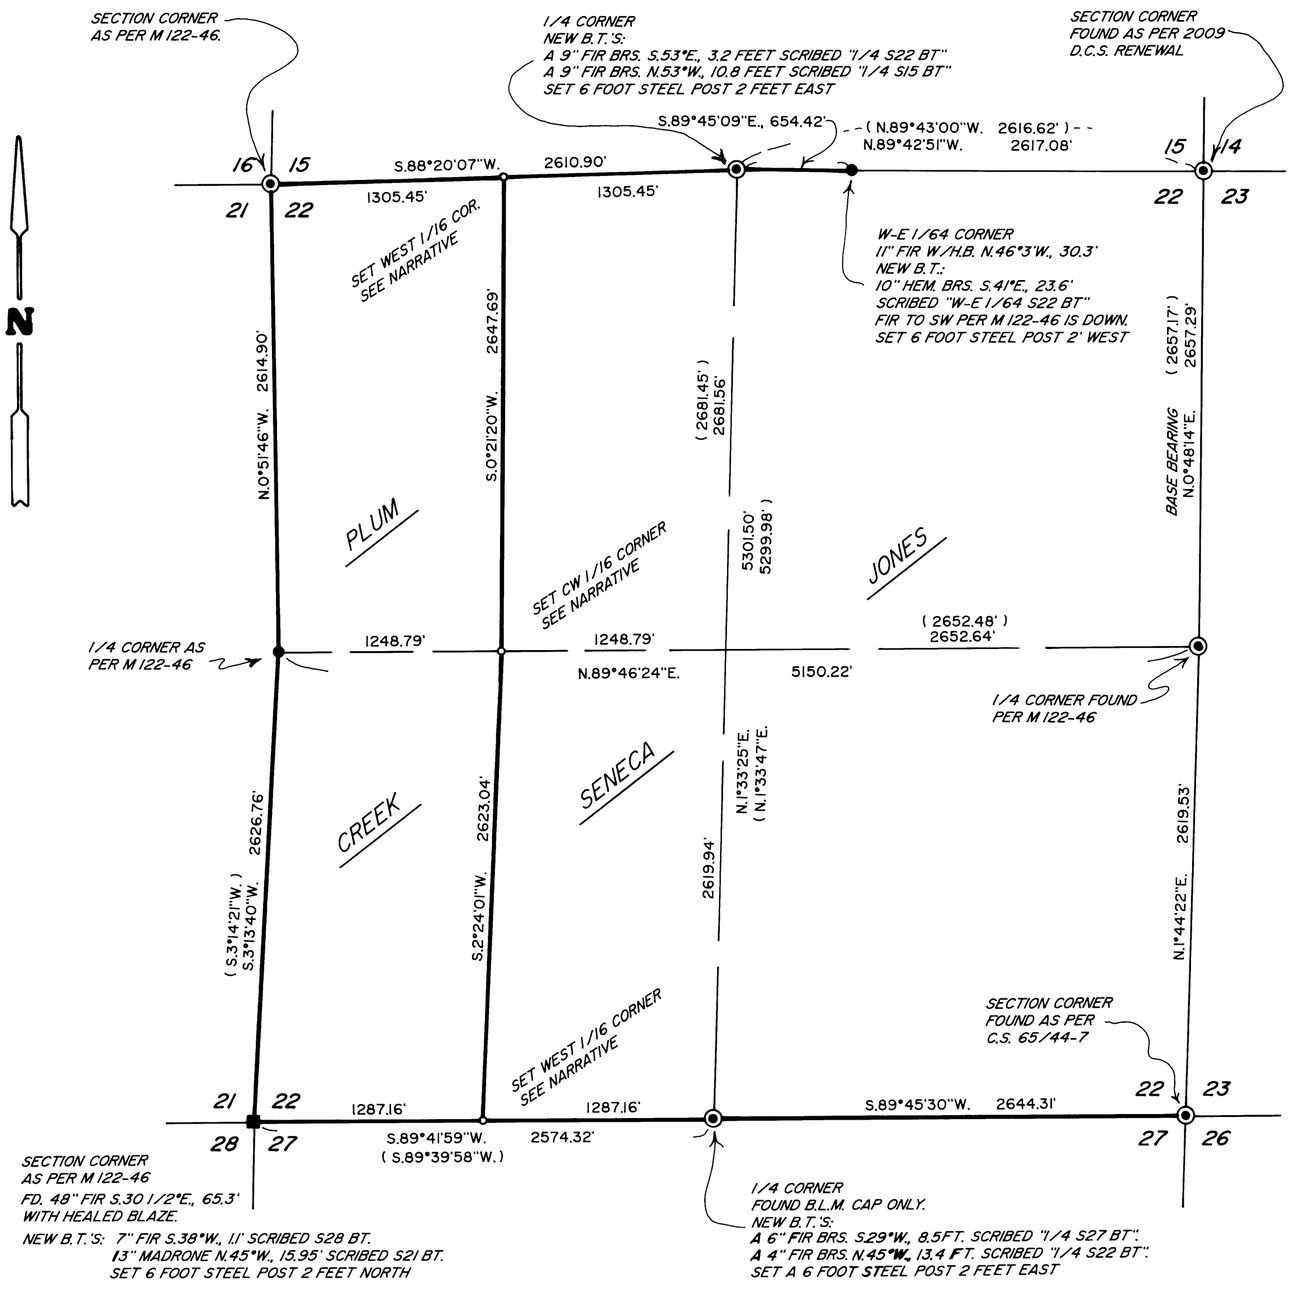

SURVEYED FOR: *SENECA JONES TIMBER CO.*
P.O. BOX 2129
ROSEBURG, OREGON 97470

AND

PLUM CREEK TIMBERLANDS L.P.
P.O. BOX 1528
COOS BAY, OREGON 97420

SURVEYED BY: *DAVID EDWARDS LAND SURVEYING*
P.O. BOX 361
OAKLAND, OREGON 97462
PHONE: (541) 459-0512

REGISTERED PROFESSIONAL LAND SURVEYOR
David A. Edwards
OREGON
JULY 26, 1989
DAVID A. EDWARDS
2339
RENEWS 12/31/11

LEGEND

- ◉ INDICATES B.L.M. OR COUNTY SURVEYOR BRASS CAP FOUND.
- ● INDICATES 5/8" DIAM. IRON ROD WITH CAP PER M 122-46.
- ■ INDICATES 2" DIAM. IRON PIPE MARKED RS 33 PER M 122-41.
- o INDICATES 5/8" X 30" STEEL REBAR WITH 2 1/2" DIAM. ALUM. CAP MARKED "LS 2339" AND "2010" AND AS PER 1973 B.L.M. MANUAL.

( ) DENOTES RECORD DATA PER M 122-46 UNLESS NOTED OTHERWISE.

SCALE: 1" = 600'

BASIS OF BEARINGS: M 122-46.

NARRATIVE

THE PURPOSE OF THIS SURVEY IS TO MARK THOSE BOUNDARIES SHOWN HEREON AS BOLD LINES BY BLAZING TREES ON EACH SIDE OF LINE, BY SETTING 6 FOOT STEEL POSTS ALONG TRUE LINE AT INTERVALS OF 200' OR LESS AND BY HANGING LIBERAL AMOUNTS OF RED FLAGGING ALONG THE TRUE LINE. BEARING TREES SCRIBED ON THIS SURVEY ARE MEASURED TO CENTER OF TREE AT ROOT CROWN AND ARE SITUATED AS FOLLOWS:

AT THE WEST 1/16 CORNER TO SECTIONS 15 AND 22:
AN 11" DIAM. FIR BEARS S.63°W., 18.4 FT. SCRIBED "W 1/16 S22 BT".
A 7" DIAM. FIR BEARS N.44°W., 22.0 FT. SCRIBED "W 1/16 S15 BT".
3/4" DIAM. IRON PIPE PER C.S. 41/302 BEARS N.66°27'31"W., 7.47 FT.
SET 6 FOOT STEEL POST 2' SOUTH

AT THE CENTER-WEST 1/16 CORNER:
A 10" DIAM. FIR BEARS N.86°W., 12.4 FEET.
A 12" DIAM. FIR BEARS N.5°W., 20.4 FEET.
BOTH SCRIBED "CW 1/16 S22 BT"
SET 6 FOOT STEEL POST 2' NORTH

AT THE WEST 1/16 CORNER TO SECTIONS 22 AND 27:
A 5" DIAM. FIR BEARS S.11°E., 7.1 FT. SCRIBED "W 1/16 S27 BT".
A 5" DIAM. FIR BEARS N.70°W., 9.7 FT. SCRIBED "W 1/16 S22 BT".
3/4" DIAM. IRON PIPE PER C.S. 41/302 BEARS S.19°22'50"W., 5.27 FT.
SET 6 FOOT STEEL POST 2' NORTH.

FIELD CREW: BRANT MILLER, DAVID EDWARDS AND ERIC SPRINKLE.

EQUIPMENT: NIKON TOTAL STATION.

COMPUTATIONS AND DRAFTING: DAVID EDWARDS.

MAP FILE M161-51