# ~~BOUNDARY LINE ADJUSTMENT~~

**FOR COREY CROSS**
**LOCATED IN THE SW 1/4 OF SEC. 3,**
**TOWNSHIP 22 SOUTH, RANGE 12 WEST, W.M.**
**DOUGLAS COUNTY, OREGON**
**AUGUST 2009**

FILED AS A SURVEY ONLY

FILED
Date: 8/25/2011 By: N.W.
This survey consists of:
Map: M 162-64
Narrative:
Corner Rpt:

DOUGLAS COUNTY
SURVEYOR

MAP FILE M 162-64

**NARRATIVE:**

~~THE PURPOSE OF THIS SURVEY IS TO ADJUST THE BOUNDARY OF THE SUBJECT PROPERTY. ALL FOUND MONUMENTS WERE HELD. THE BOUNDARY LINE WAS ADJUSTED AS SHOWN.~~

~~**APPROVALS:**~~

~~CITY OF REEDSPORT, CITY MANAGER DATE~~

~~THE ADJUSTMENT OF THE PROPERTY BOUNDARY WAS EXECUTED PER RESTRICTIVE COVENANT INSTRUMENT #:~~

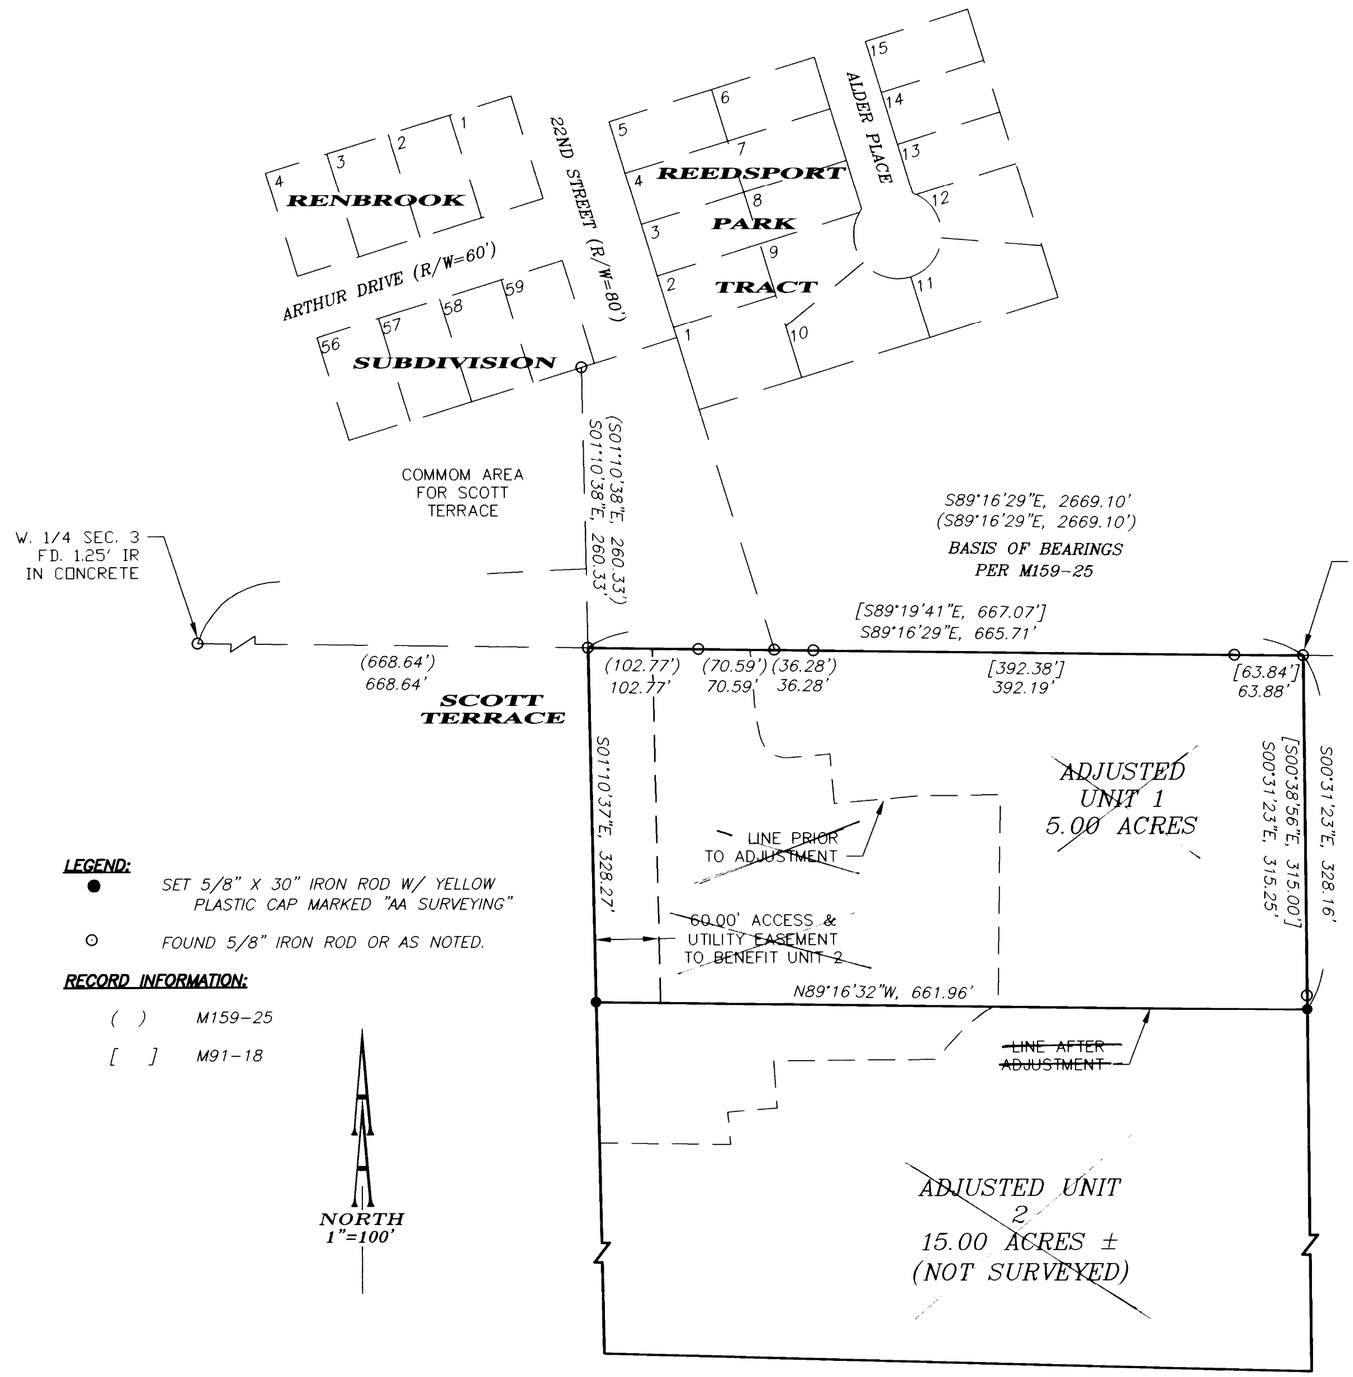


**LEGEND:**

● SET 5/8" X 30" IRON ROD W/ YELLOW PLASTIC CAP MARKED "AA SURVEYING"

⊙ FOUND 5/8" IRON ROD OR AS NOTED.

**RECORD INFORMATION:**

( ) M159-25

[ ] M91-18

REGISTERED
PROFESSIONAL
LAND SURVEYOR
OREGON
NOVEMBER 30, 2007
MICHAEL P. SCHULZE
71827
EXP. DATE: 6-30-12


**SURVEYING & ENGINEERING, INC.**
**ENGINEERING•SURVEYING•PLANNING**
3076 NE DIAMOND LAKE BLVD.
ROSEBURG, OREGON 97470
TEL (541)672-2096
FAX (541)672-0611


MAP FILE M 162-64