Prepared for:
ROBERT BRASHEAR
1656 YEUST ROAD
AZEALA, OR. 97410

Prepared by:
RAYMOND F. BROWN - P.L.S. # 2391
P.O. BOX 539
CANYONVILLE, OR. 97417
Phone: (541) 839-6185

PROPERTY LINE SURVEY

Located in the:
SOUTHEAST QUARTER OF SECTION 6,
TOWNSHIP 32 SOUTH, RANGE 4 WEST,
WILLAMETTE MERIDIAN, DOUGLAS COUNTY, OREGON.

FILED
Date: 11-9-2011 By: JC
This survey consists of:
Map: M 163-1
Narrative:
Corner Rpt:
DOUGLAS COUNTY SURVEYOR

MAP FILE M163-1

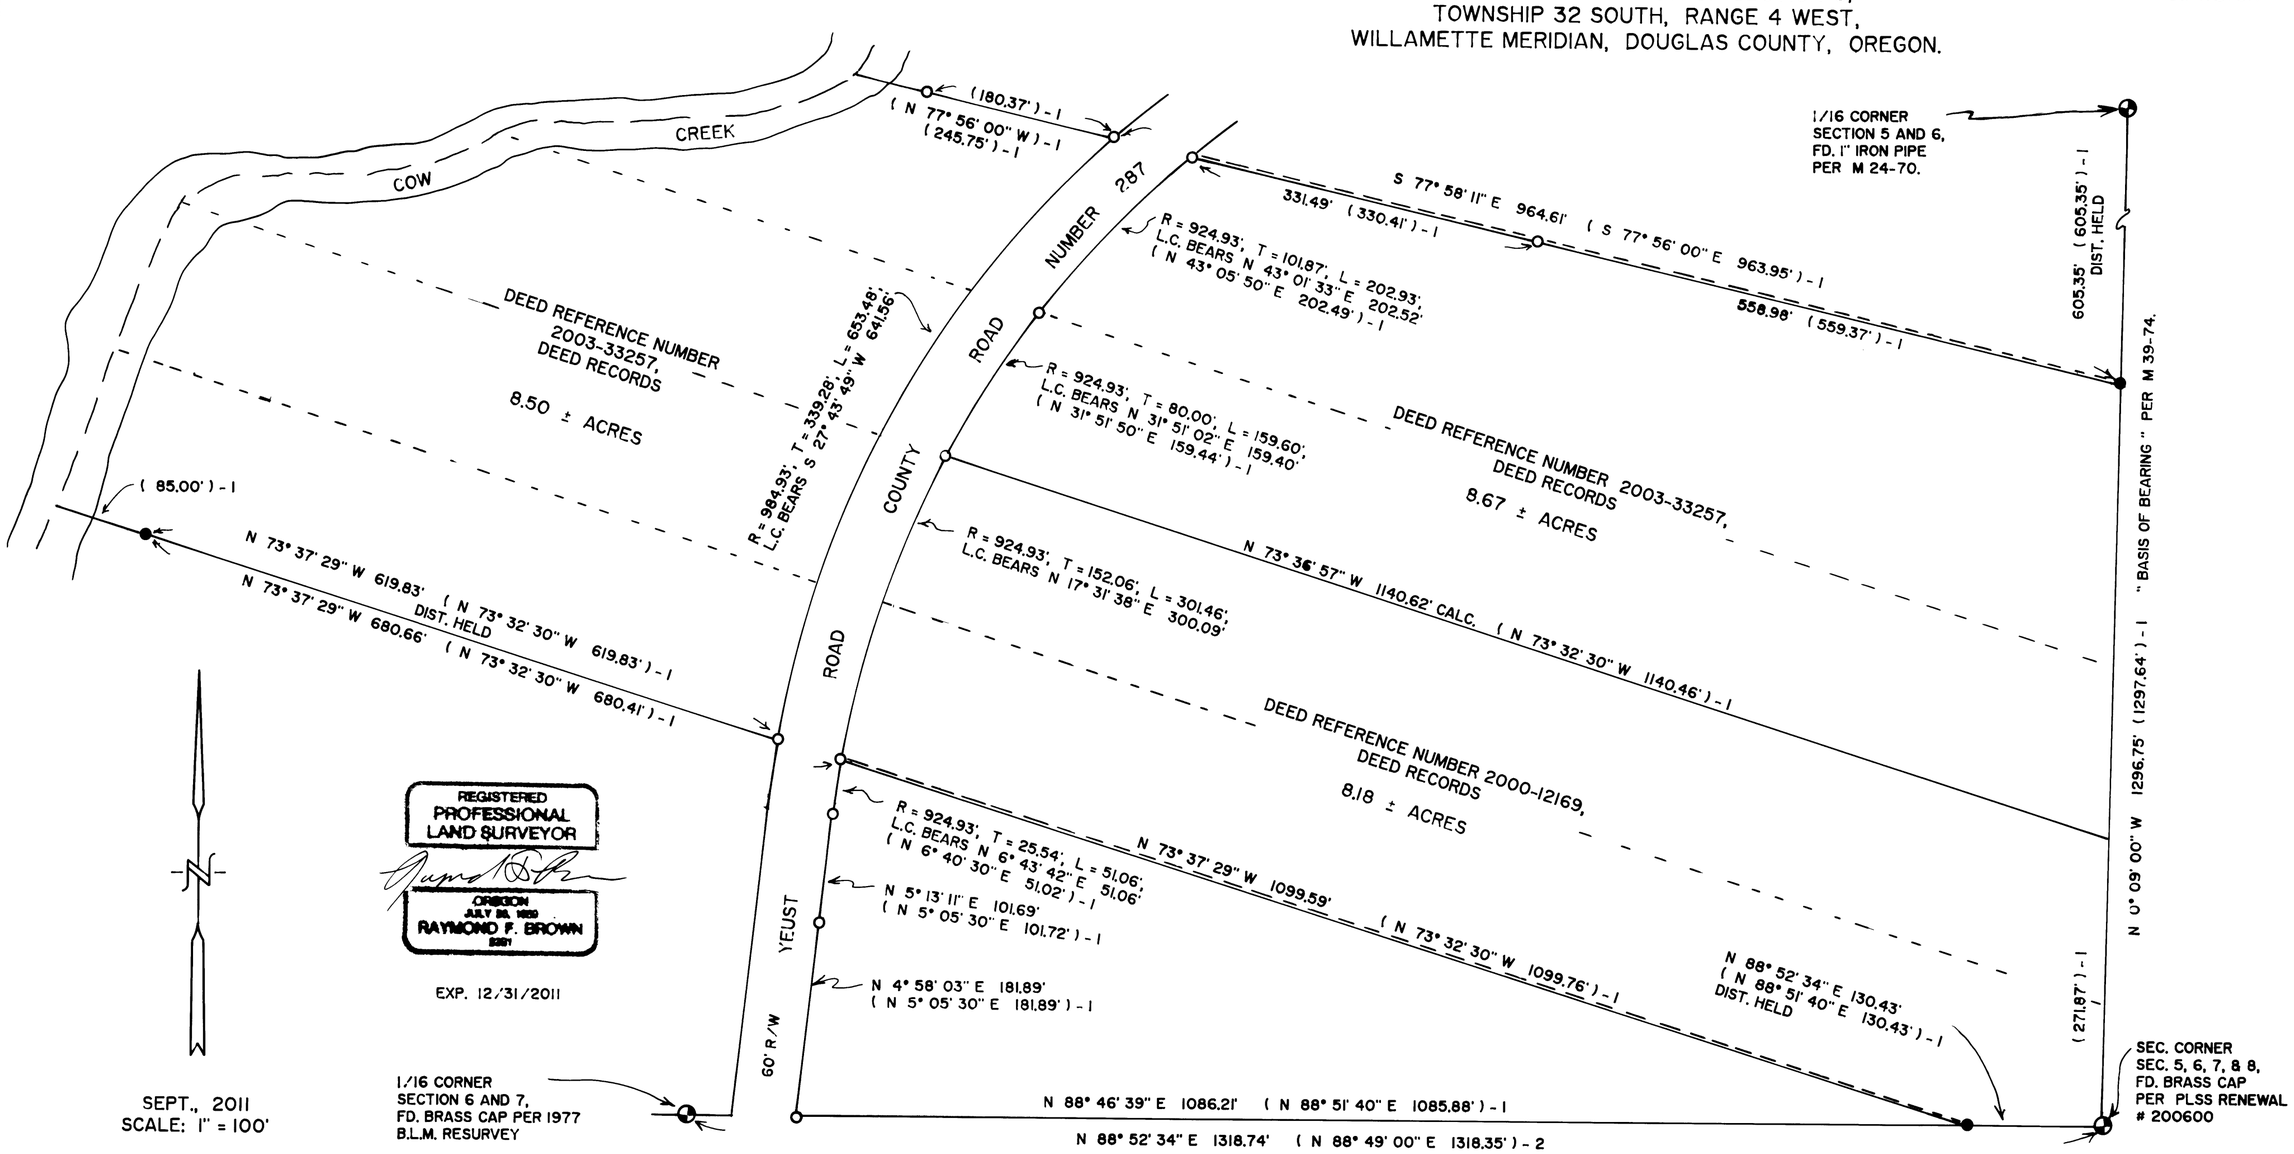

REGISTERED PROFESSIONAL LAND SURVEYOR
OREGON
JULY 24, 1979
RAYMOND F. BROWN
2391

EXP. 12/31/2011

SEPT., 2011
SCALE: 1" = 100'

LEGEND:

- ○ FD. 5/8" IRON ROD PER M 39-74.
- ● SET 5/8" X 30" IRON ROD WITH PLASTIC CAP ATTACHED, MKD. " R. BROWN, PLS 2391 ".
- ( ) - 1 RECORD AS PER M 39-74.
- ( ) - 2 RECORD AS PER 1977 B.L.M. RESURVEY.
- ═══ BOUNDARY BLAZED FOR LOGGING.

NARRATIVE:

PURPOSE OF THE SURVEY WAS TO DEFINE THE NORTH AND SOUTH BOUNDARIES AS SHOWN. FIELD INVESTIGATION LOCATED THE SAID FOUND MONUMENTS AND CONDITIONS. THE NORTHEAST CORNER WAS SET ON THE NORTH-SOUTH SECTION LINE AT RECORD DISTANCE FROM THE SOUTH 1/16TH. CORNER, AS THIS FITS THE EXISTING MONUMENTS ALONG THE SAID NORTH BOUNDARY WELL. THE SAID SET MONUMENTS NEAR THE SOUTHEAST CORNER WAS SET ALONG THE SOUTHERLY SECTION LINE OF SECTION 6 AT RECORD DISTANCE FROM THE SOUTHEAST SECTION CORNER. THIS WAS COMPLETED BY RE-TRACING THE 1977 B.L.M. RESURVEY ALONG THIS PORTION OF THE SECTION LINE. THE SET MONUMENTS NEAR THE SOUTHWEST CORNER WAS SET AT RECORD DISTANCE FROM THE COUNTY ROAD RIGHT OF WAY, ON THE SAME BEARING CALCULATED FOR THE SAID SOUTH BOUNDARY PER M 39-74.

MAP FILE M163-1