MAP OF SURVEY

LOCATED in the West 1/2 of Sec. 35, T. 27 S., R. 3 W., W.M.
in Douglas County, Oregon.

March 13, 2012

FILED
Date: 3-22-2012 By: JC
This survey consists of:
Map: M 163-38
Narrative:
Corner Rpt:
DOUGLAS COUNTY
SURVEYOR

MAP FILE M163-38

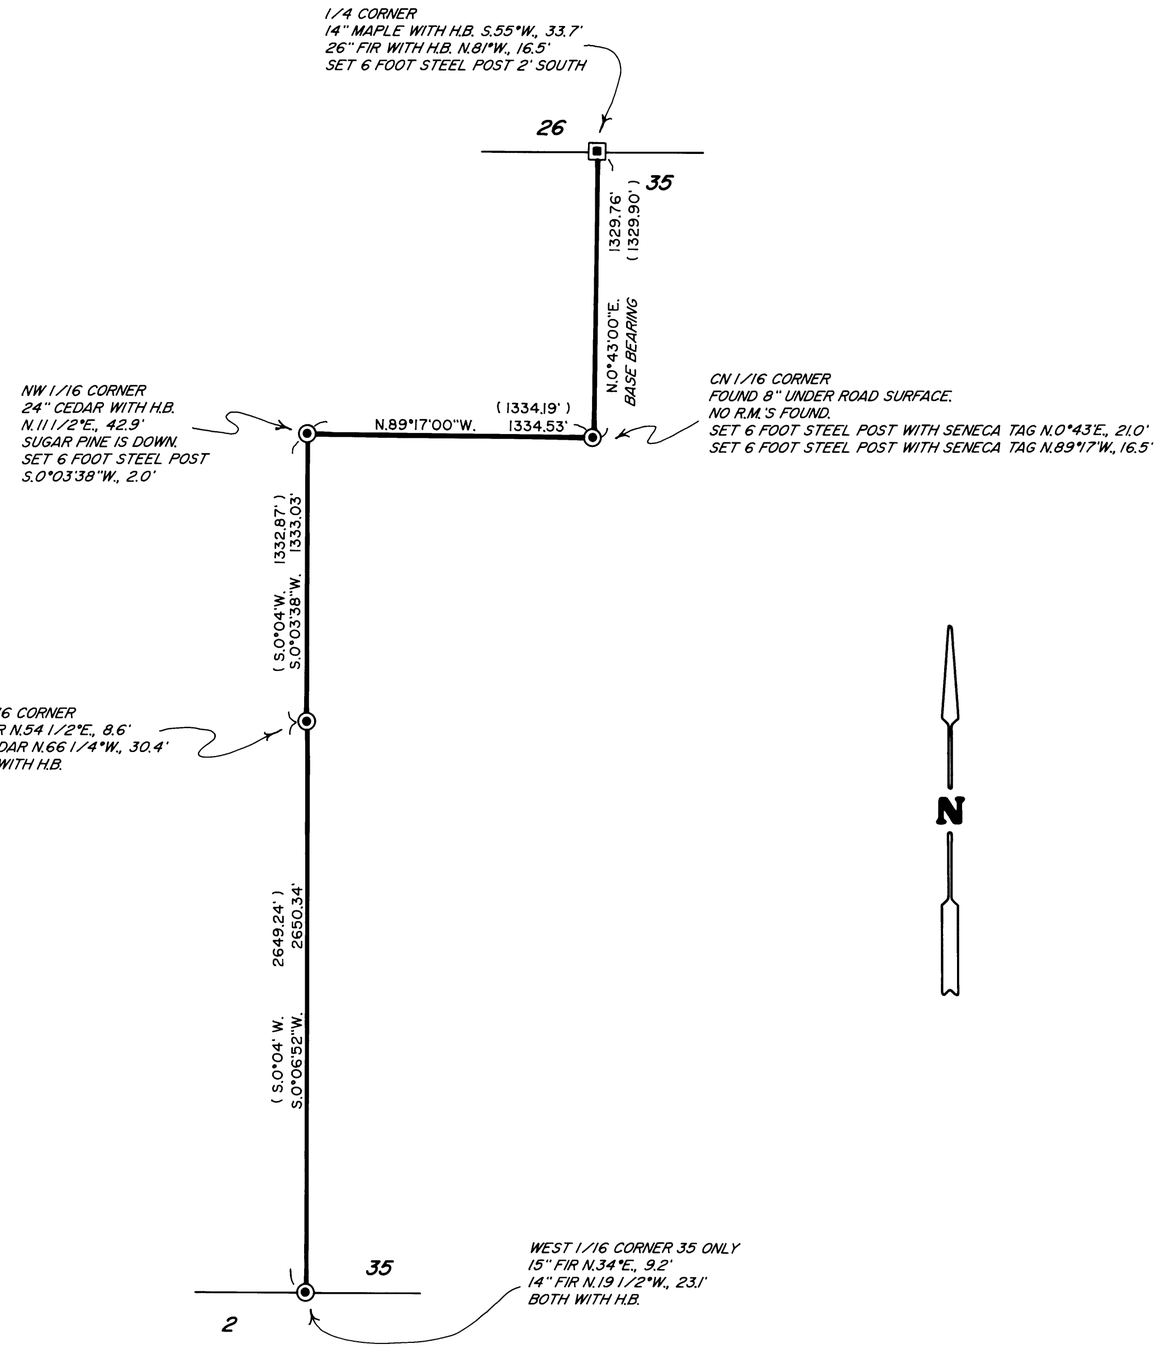

SURVEYED FOR: *SENECA JONES TIMBER CO.*
P.O. BOX 2129
ROSEBURG, OREGON 97470

SURVEYED BY: *DAVID EDWARDS LAND SURVEYING*
P.O. BOX 361
OAKLAND, OREGON 97462
PHONE: (541) 459-0512

REGISTERED PROFESSIONAL LAND SURVEYOR
David A. Edwards
OREGON
JULY 24, 1990
DAVID A. EDWARDS
2239
RENEWS 12/31/13

LEGEND

- ▣ INDICATES ALUMINUM CAPPED IRON PIPE FOUND PER M 95-77.
- ◉ INDICATES B.L.M. BRASS CAP FOUND PER 1985 SUBDIVISION OF SECTION 35.
- ( ) DENOTES RECORD DATA PER 1985 B.L.M. SURVEY.
- ━━━ INDICATES BOUNDARY BLAZED AND POSTED THIS SURVEY.

SCALE: 1" = 500' H.B. = HEALED BLAZE.

BASIS OF BEARINGS: 1985 B.L.M. SURVEY AS SHOWN.

NARRATIVE

THE PURPOSE OF THIS SURVEY IS TO MARK THOSE BOUNDARIES SHOWN AS BOLD LINES HEREON. THE BOUNDARIES WERE MARKED BY BLAZING TREES ON EACH SIDE OF THE LINE, BY SETTING 6 FOOT STEEL POSTS ALONG LINE AT INTERVALS OF 200' OR LESS AND BY HANGING LIBERAL AMOUNTS OF RED FLAGGING ALONG THE TRUE LINE.

FIELD CREW: DAVID EDWARDS AND BRANT MILLER.

EQUIPMENT: NIKON TOTAL STATION.

COMPUTATIONS AND DRAFTING: DAVID EDWARDS.

MAP FILE M163-38