FILED
Date: 11-5-2012 By: JC
This survey consists of:
Map: M164-31
Narrative:
Corner Rpt:

DOUGLAS COUNTY
SURVEYOR

MAP FILE M164-31

A SURVEY FOR STEVE & DIANE LOUNSBURY

LOCATED IN THE NW 1/4 OF SECTION 6, T29S, R8W, W.M.,
DOUGLAS COUNTY, OREGON

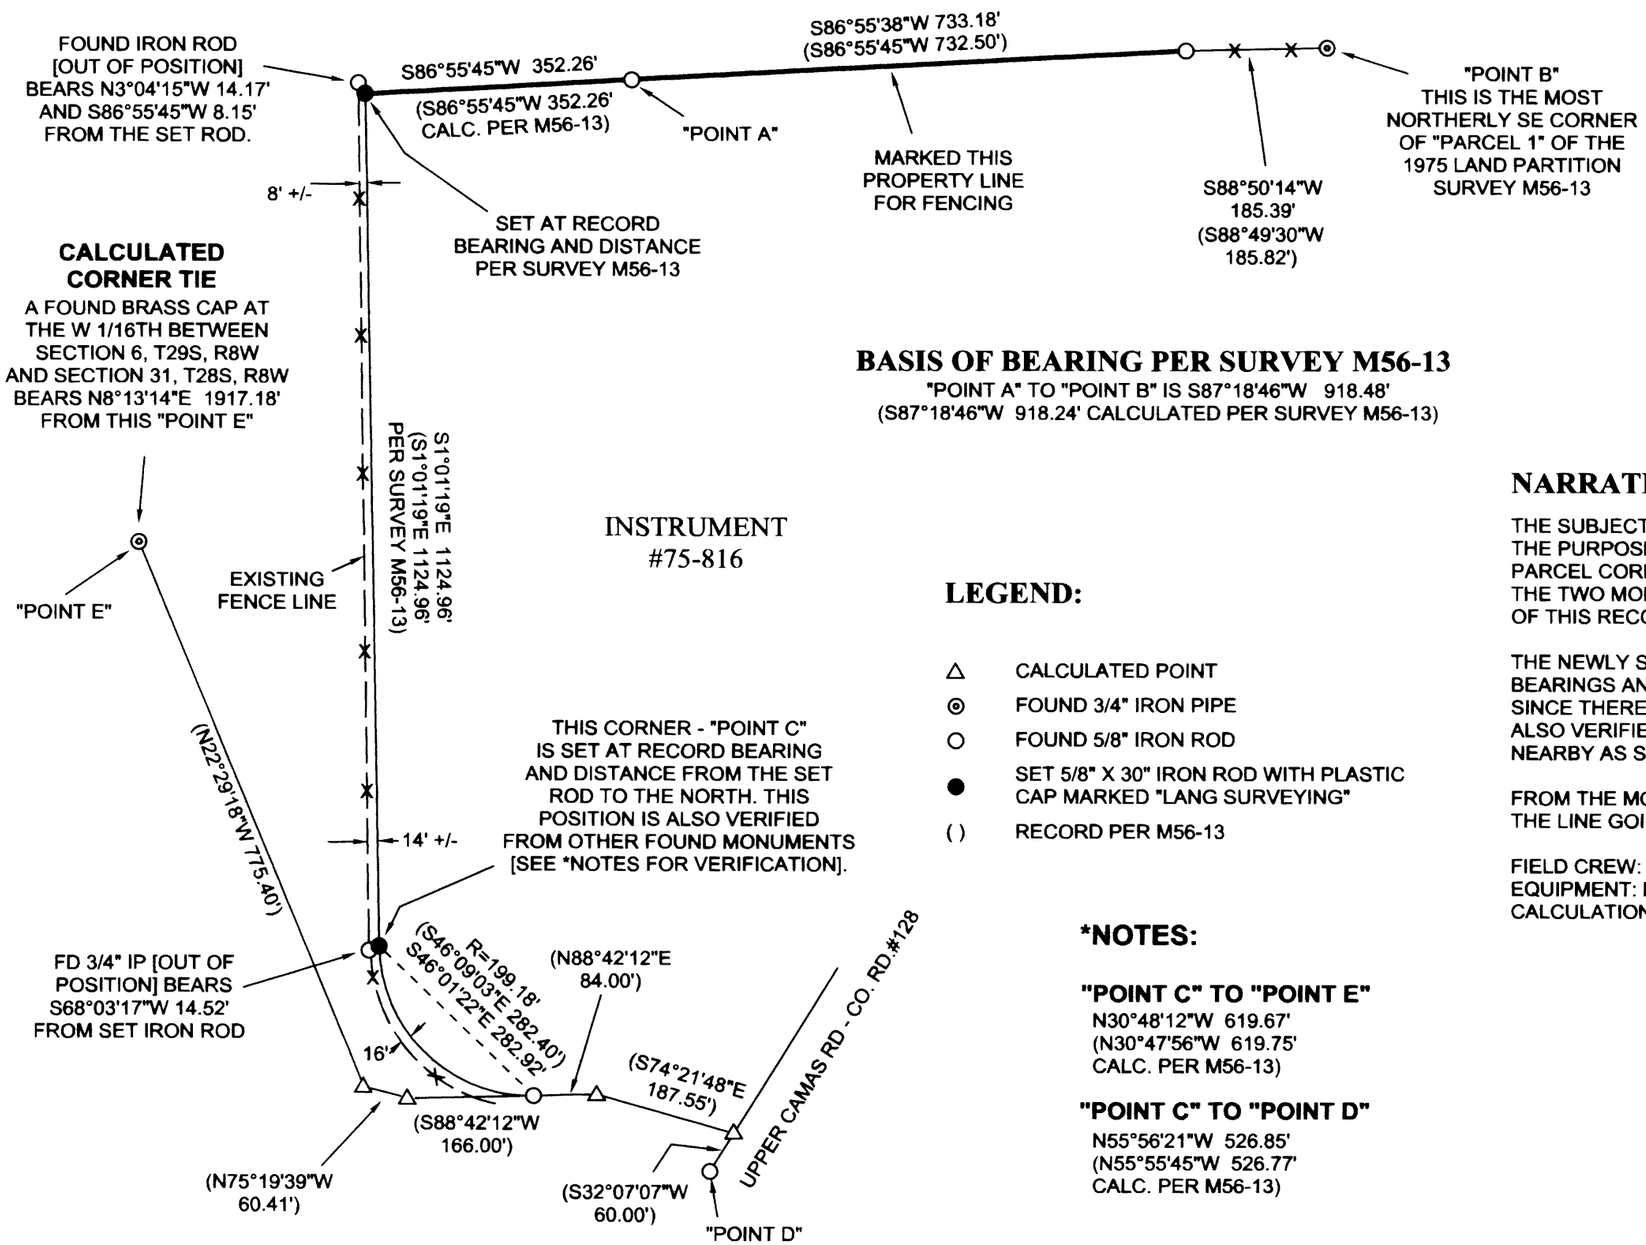

N

0 200'

JULY 2012

BASIS OF BEARING PER SURVEY M56-13

"POINT A" TO "POINT B" IS S87°18'46"W 918.48'
(S87°18'46"W 918.24' CALCULATED PER SURVEY M56-13)

LEGEND:

- △ CALCULATED POINT
- ⊙ FOUND 3/4" IRON PIPE
- ○ FOUND 5/8" IRON ROD
- ● SET 5/8" X 30" IRON ROD WITH PLASTIC CAP MARKED "LANG SURVEYING"
- ( ) RECORD PER M56-13

*NOTES:

"POINT C" TO "POINT E"
N30°48'12"W 619.67'
(N30°47'56"W 619.75'
CALC. PER M56-13)

"POINT C" TO "POINT D"
N55°56'21"W 526.85'
(N55°55'45"W 526.77'
CALC. PER M56-13)

NARRATIVE:

THE SUBJECT PROPERTY IS "PARCEL 1" OF SURVEY M56-13.
THE PURPOSE OF THE PROJECT IS TO MONUMENT TWO OF THE PARCEL CORNERS IN THEIR RECORD POSITION USING SAID SURVEY. THE TWO MONUMENTS FOUND IN THE NEARBY FENCE WERE OUT OF THIS RECORD LOCATION.

THE NEWLY SET CORNERS WERE POSITIONED BY HOLDING RECORD BEARINGS AND DISTANCES FROM THE POINT DESIGNATED AS "POINT A". SINCE THERE APPEARED TO BE PROBLEMS, THESE POSITIONS WERE ALSO VERIFIED BY RECORDS FROM OTHER FOUND MONUMENTS NEARBY AS SHOWN.

FROM THE MOST NORTHERLY OF THE TWO SET RODS, WE ALSO MARKED THE LINE GOING EASTERLY AS REQUESTED BY THE LOUNSBURYS.

FIELD CREW: G. LANG, L. LANG, T. LANG
EQUIPMENT: NIKON DTM 420
CALCULATIONS: G. LANG

REGISTERED
PROFESSIONAL
LAND SURVEYOR
OREGON
GREGORY D. LANG
July 16, 1987
#2295

EXPIRES: 12-31-2012

SURVEYED BY:
GREGORY D. LANG
7550 WILLIS CR. RD.
WINSTON, OR. 97496

MAP FILE M164-31