PROPERTY LINE ADJUSTMENT

MAP OF SURVEY

LOCATED in the SW 1/4 of Section 35, T. 30 S., R. 6 W., W.M.
in Douglas County, Oregon.

April 24, 2013

FILED
Date: 6/11/2013 By: NW
This survey consists of:
Map: M 165-32
Narrative:
Corner Rpt:
DOUGLAS COUNTY
SURVEYOR

MAP FILE M 165-32

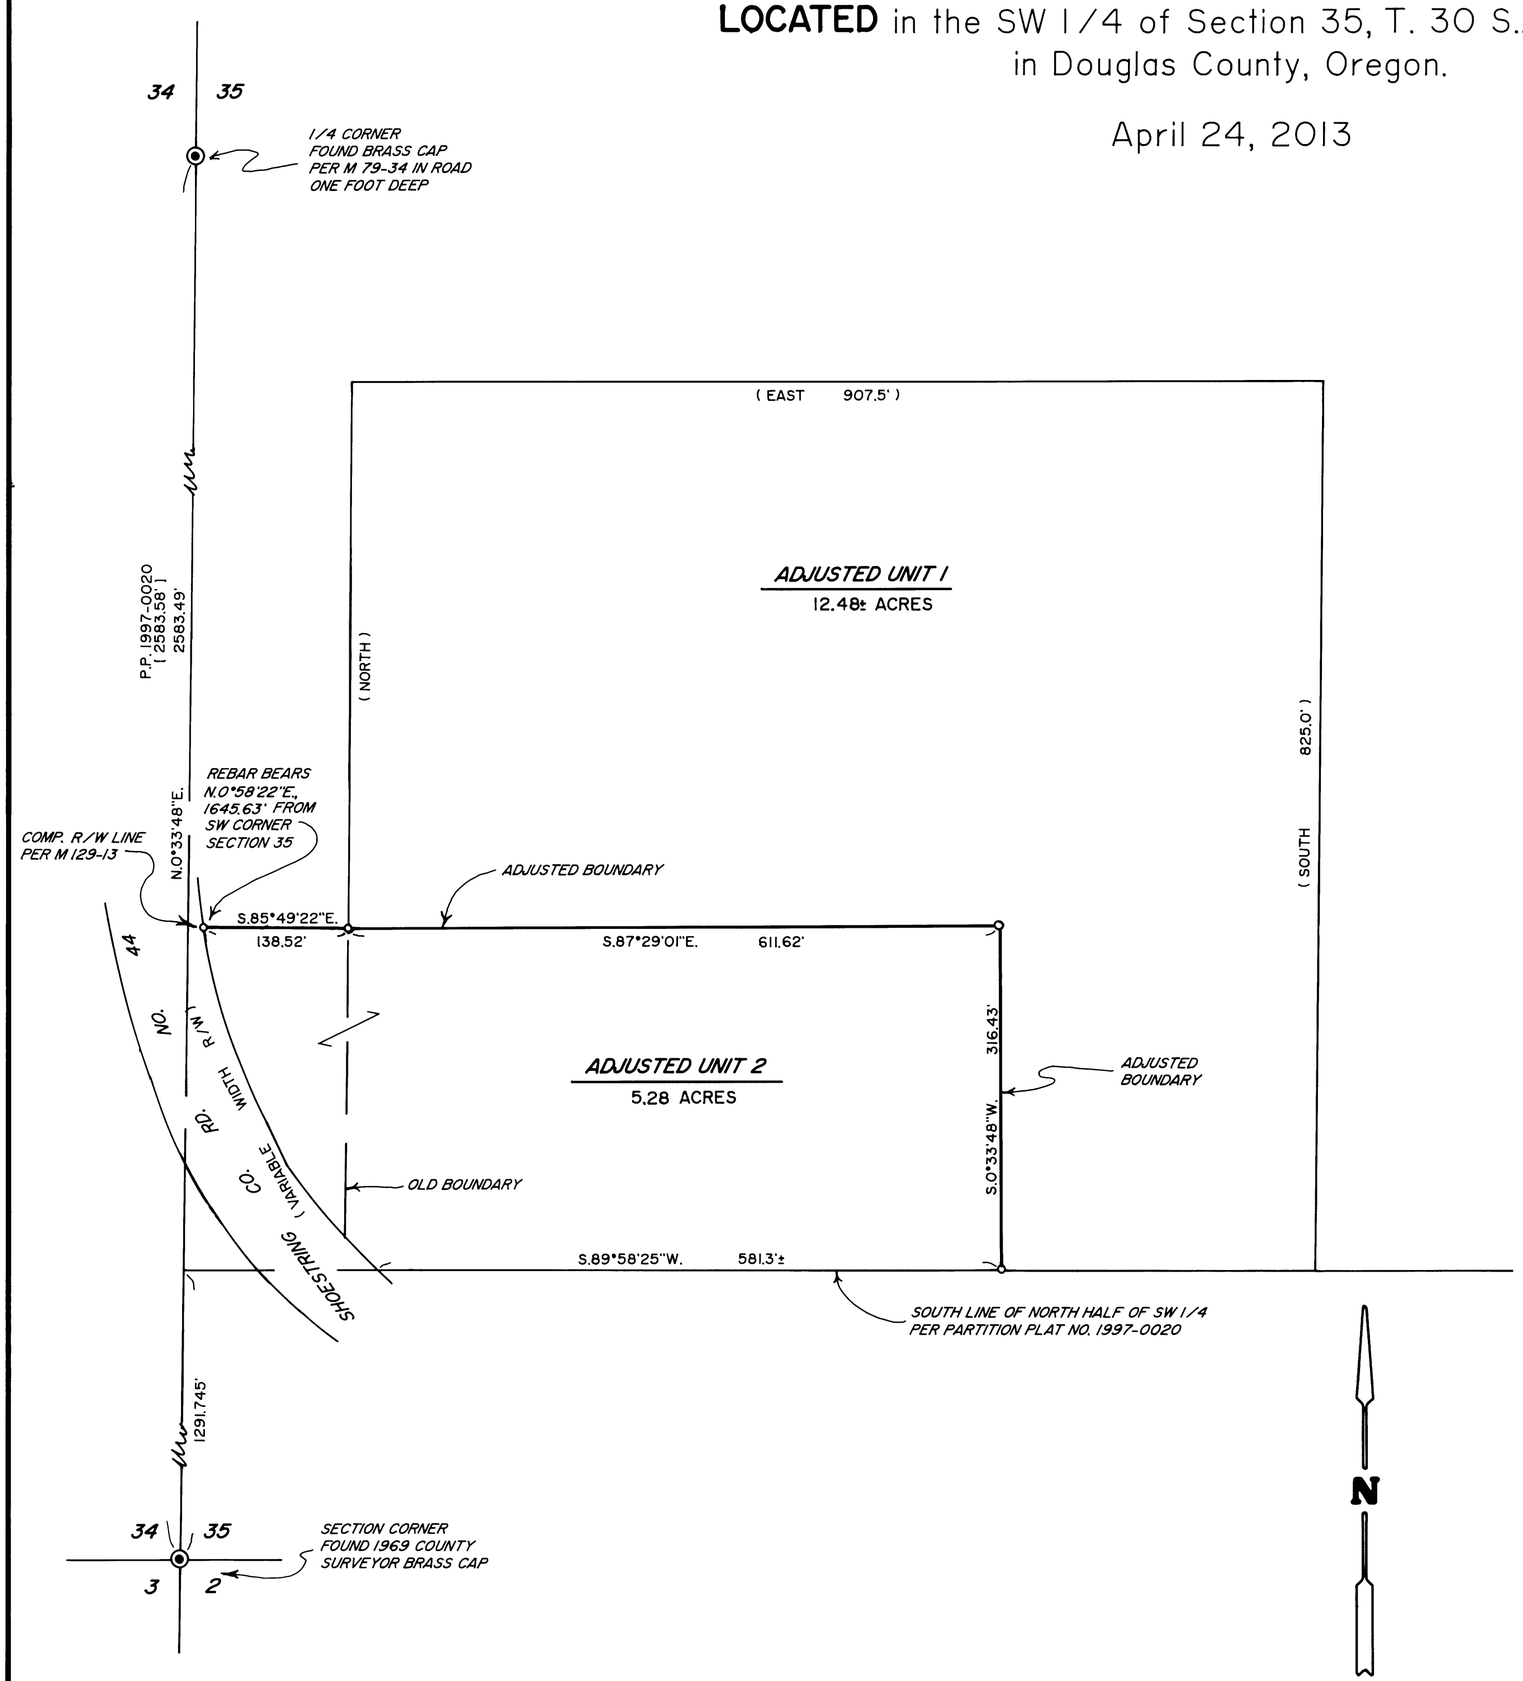

SURVEYED FOR: *CODY AND TAMI HACKETT*
P.O. BOX 1093
RIDDLE, OREGON 97469

REGISTERED PROFESSIONAL LAND SURVEYOR
David A. Edwards
OREGON
JULY 26, 1990
DAVID A. EDWARDS
2339
RENEWS 12/31/13

SURVEYED BY: *DAVID EDWARDS LAND SURVEYING*
P.O. BOX 361
OAKLAND, OREGON 97462
PHONE: (541) 459-0512

LEGEND

- ◉ INDICATES BRASS CAP FOUND.
- o INDICATES 5/8" X 30" STEEL REBAR W/RED PLASTIC CAP MKD. "D.A. EDWARDS-LS 2339" SET.
- ( ) DENOTES DEED RECORD DATA.

SCALE: 1" = 100' COMP. = COMPUTED

BASIS OF BEARINGS: PARTITION PLAT NO. 1997-0020 AS SHOWN.

NARRATIVE

THE PURPOSE OF THIS SURVEY IS TO MONUMENT THE ADJUSTED BOUNDARY SHOWN HEREON AND TO PREPARE A LEGAL DESCRIPTION OF ADJUSTED UNIT 2 FOR USE IN CONVEYING SAME. THE SECTION AND 1/4 CORNERS WERE USED FOR CONTROL AS SHOWN.

FIELD CREW: BRANT MILLER AND ERIC SPRINKLE.

EQUIPMENT: NIKON TOTAL STATION.

COMPUTATIONS AND DRAFTING: DAVID EDWARDS.

ADJUSTMENT DOCUMENT: *2013-010008*

APPROVAL

PLANNING FILE NO. M13-008

Keith L. Cubic 6/11/13
DOUGLAS COUNTY PLANNING DIRECTOR DATE

MAP FILE M 165-32