MAP FILE M166-23 A
REVISED SEE M166-37 A-C

RECORD OF SURVEY

LOCATED IN
TOWNSHIP 28 SOUTH, RANGE 7 WEST, W.M.
TOWNSHIP 29 SOUTH, RANGE 6 WEST, W.M.
DOUGLAS COUNTY, OREGON

REVISED SEE M166-37 A-C

FILED
Date: 12-4-2014 By: JC
This Survey consists of
Map: M166-23 A-C
Narrative: REVISED SEE M166-37 A-C
Corner Rpt: _____
DOUGLAS COUNTY
SURVEYOR

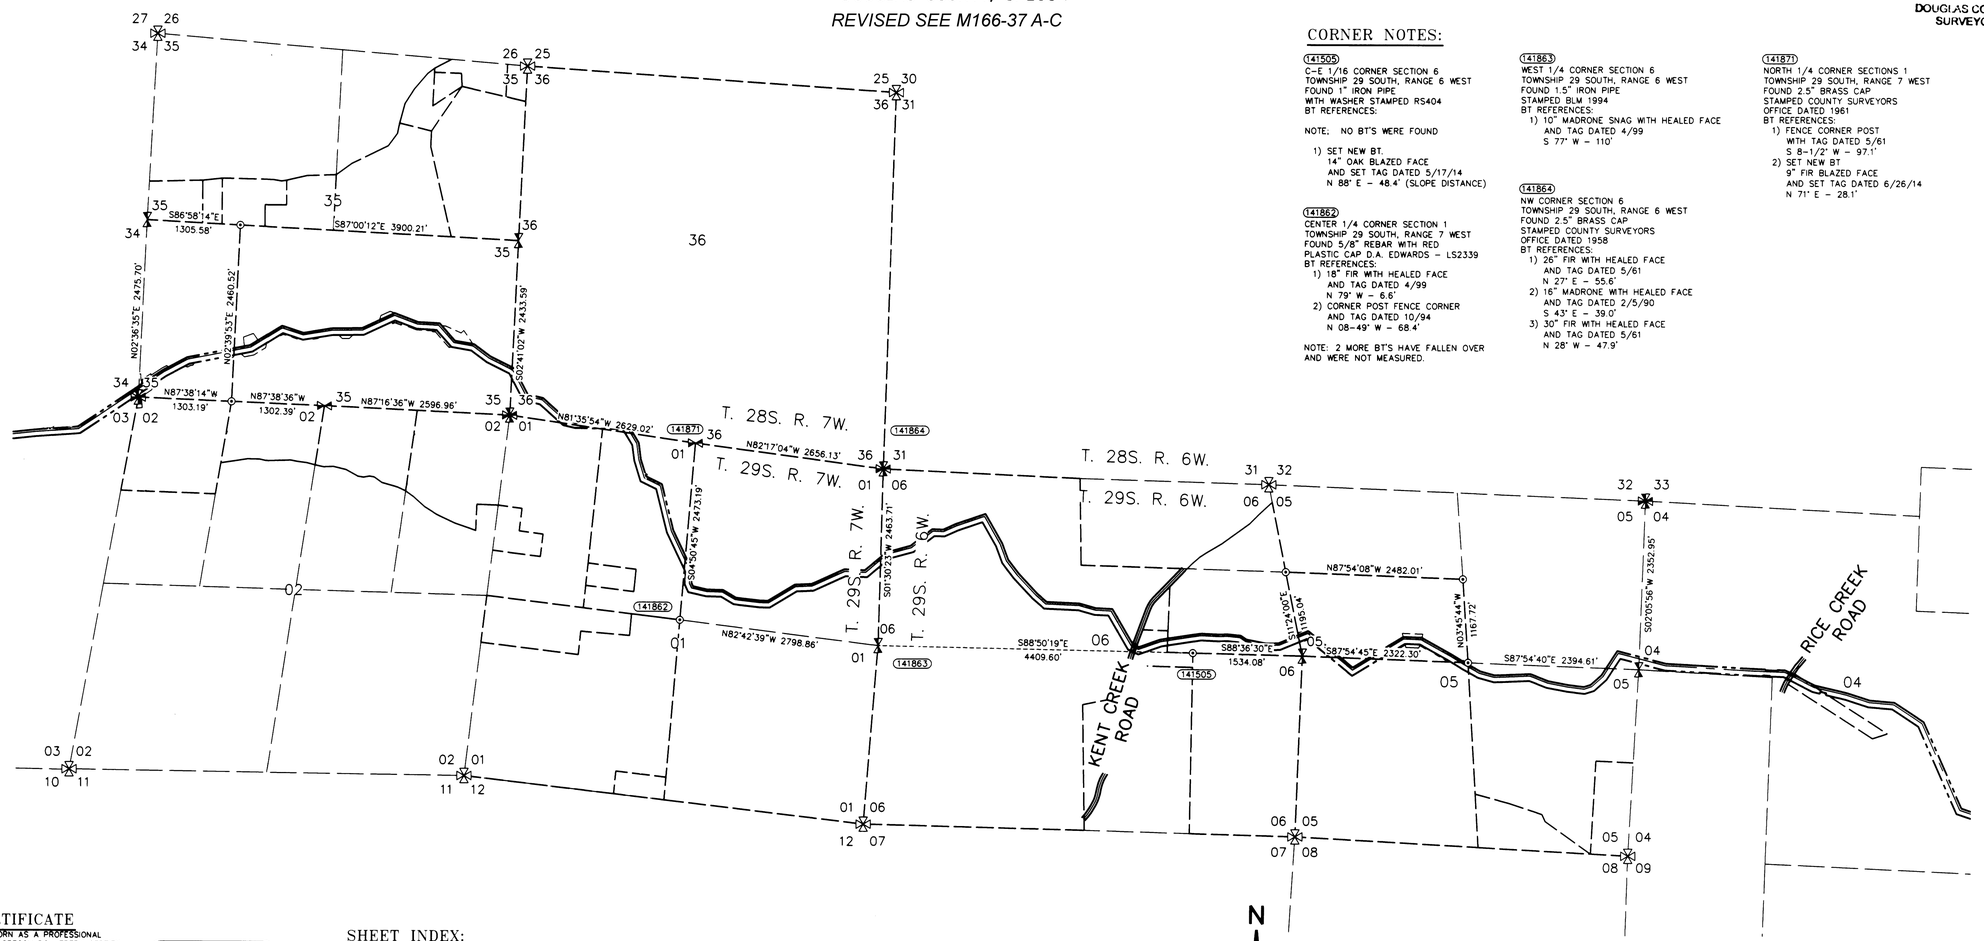

CORNER NOTES:

(141505)
C-E 1/16 CORNER SECTION 6
TOWNSHIP 29 SOUTH, RANGE 6 WEST
FOUND 1" IRON PIPE
WITH WASHER STAMPED RS404
BT REFERENCES:

NOTE: NO BT'S WERE FOUND

1) SET NEW BT.
14" OAK BLAZED FACE
AND SET TAG DATED 5/17/14
N 88° E - 48.4' (SLOPE DISTANCE)

(141862)
CENTER 1/4 CORNER SECTION 1
TOWNSHIP 29 SOUTH, RANGE 7 WEST
FOUND 5/8" REBAR WITH RED
PLASTIC CAP D.A. EDWARDS - LS2339
BT REFERENCES:
1) 18" FIR WITH HEALED FACE
AND TAG DATED 4/99
N 79° W - 6.6'
2) CORNER POST FENCE CORNER
AND TAG DATED 10/94
N 08-49° W - 68.4'

NOTE: 2 MORE BT'S HAVE FALLEN OVER
AND WERE NOT MEASURED.

(141863)
WEST 1/4 CORNER SECTION 6
TOWNSHIP 29 SOUTH, RANGE 6 WEST
FOUND 1.5" IRON PIPE
STAMPED BLM 1994
BT REFERENCES:
1) 10" MADRONE SNAG WITH HEALED FACE
AND TAG DATED 4/99
S 77° W - 110'

(141864)
NW CORNER SECTION 6
TOWNSHIP 29 SOUTH, RANGE 6 WEST
FOUND 2.5" BRASS CAP
STAMPED COUNTY SURVEYORS
OFFICE DATED 1958
BT REFERENCES:
1) 26" FIR WITH HEALED FACE
AND TAG DATED 5/61
N 27° E - 55.6'
2) 16" MADRONE WITH HEALED FACE
AND TAG DATED 2/5/90
S 43° E - 39.0'
3) 30" FIR WITH HEALED FACE
AND TAG DATED 5/61
N 28° W - 47.9'

(141871)
NORTH 1/4 CORNER SECTIONS 1
TOWNSHIP 29 SOUTH, RANGE 7 WEST
FOUND 2.5" BRASS CAP
STAMPED COUNTY SURVEYORS
OFFICE DATED 1961
BT REFERENCES:
1) FENCE CORNER POST
WITH TAG DATED 5/61
S 8-1/2° W - 97.1'
2) SET NEW BT
9" FIR BLAZED FACE
AND SET TAG DATED 6/26/14
N 71° E - 28.1'

SURVEYOR'S CERTIFICATE

I, JAMES M. KLEIN BEING DULY SWORN AS A PROFESSIONAL LAND SURVEYOR IN THE STATE OF OREGON DO HEREBY CERTIFY THAT THIS MAP CORRECTLY REPRESENTS A SURVEY CONDUCTED UNDER MY DIRECT SUPERVISION IN CONFORMANCE WITH THE REQUIREMENTS OF THE SURVEY RECORDING LAW, AS ESTABLISHED BY ORS CHAPTER 209, AND HAVE SET THE PROPER MONUMENTS AS REFERENCED IN THE LEGEND BY MY REGISTRATION NUMBER AND SEAL.

FURTHERMORE, I APPROVE THE LOCATION OF THE MONUMENTS AS DEPICTED ON THIS SURVEY DRAWING TO BE IN THEIR PROPER LOCATION.

JAMES M. KLEIN PLS. 59002

REGISTERED PROFESSIONAL LAND SURVEYOR
OREGON
JULY 12, 2005
JAMES M. KLEIN
59002
Expires 6-30-2015

SURVEYOR'S CERTIFICATE

I, MICHAEL W. ERICKSON BEING DULY SWORN AS A PROFESSIONAL LAND SURVEYOR IN THE STATE OF OREGON DO HEREBY CERTIFY THAT THIS MAP CORRECTLY REPRESENTS A SURVEY CONDUCTED UNDER MY DIRECT SUPERVISION IN CONFORMANCE WITH THE REQUIREMENTS OF THE SURVEY RECORDING LAW, AS ESTABLISHED BY ORS CHAPTER 209, AND HAVE SET THE PROPER MONUMENTS AS REFERENCED IN THE LEGEND BY MY REGISTRATION NUMBER AND SEAL.

FURTHERMORE, I APPROVE THE LOCATION OF THE MONUMENTS AS DEPICTED ON THIS SURVEY DRAWING TO BE IN THEIR PROPER LOCATION.

MICHAEL W. ERICKSON PLS. 2340

REGISTERED PROFESSIONAL LAND SURVEYOR
OREGON
JULY 26, 1988
MICHAEL W. ERICKSON
2340
Expires 12-31-2015

SURVEY PERFORMED FOR:
WILLIAMS
DATE OF MONUMENTATION: SEPTEMBER 23, 2014
PROJECT: 14-02-05 DRAFT: GD, LS
FILE: RS-29S-06W.DWG

SHEET INDEX:

SHEET 1 = COVER PAGE, TOWNSHIP OVERVIEW.
SHEET 2 = SECTION 35, TOWNSHIP 28 SOUTH, RANGE 7 WEST
SHEET 3 = SECTION 5, TOWNSHIP 29 SOUTH, RANGE 6 WEST

NARRATIVE

THE PURPOSE OF THIS SURVEY IS TO MONUMENT THE TEMPORARY CONSTRUCTION CORRIDOR FOR THE WILLIAMS PACIFIC CONNECTOR GAS LINE WITHIN THE BLM LANDS, LOCATED IN SECTION 35, TOWNSHIP 28 SOUTH, RANGE 7 WEST, AND SECTION 5, TOWNSHIP 29 SOUTH, RANGE 6 WEST OF THE WILLAMETTE MERIDIAN.

THE PUBLIC LAND SURVEY SYSTEM MONUMENTS WERE FOUND AND TIED BY KLEIN & ASSOCIATES.

THE TEMPORARY CONSTRUCTION EASEMENT WAS SURVEYED AND MONUMENTED BY THE DYER PARTNERSHIP.

THE INTERSECTION OF THE TEMPORARY CONSTRUCTION EASEMENT AND THE FEDERAL LANDS WERE MONUMENTED BY KLEIN & ASSOCIATES.

SCALE FACTOR NOTE

THE DISTANCES SHOWN ON THIS SURVEY ARE GRID DISTANCES.
THE COMBINED SCALE FACTOR = 0.999804944
TO CONVERT FROM GRID TO GROUND MULTIPLY THE DISTANCE BY 1.000195094.

EXAMPLE: 300.00' GRID DISTANCE
300.00' x 1.000195094 = 300.06' GROUND DISTANCE.

LEGEND

- ○ SET 5/8" X 24" REBAR WITH 1 1/4" YELLOW PLASTIC CAP (KLEIN & ASSOC. LS 59002)
- ⊗ SET 5/8" X 24" REBAR WITH 1 1/4" YELLOW PLASTIC CAP (DYER PARTNER LS 2340)
- ⊙ FOUND MONUMENT AS NOTED (SEE CORNER NOTES)
- • COMPUTED POINT, NOT MONUMENTED
- FOUND QUARTER CORNER SEE CORNER NOTES
- FOUND SECTION CORNER SEE CORNER NOTES
- COMPUTED QUARTER CORNER
- COMPUTED SECTION CORNER
- (100000) POINT NUMBER
- PROPOSED ALIGNMENT
- TEMPORARY CONSTRUCTION EASEMENT
- TEMPORARY WORK AREA

N

1000 0 1000 2000
SCALE - FEET

BASIS OF BEARINGS

OREGON STATE PLANE COORDINATE
SYSTEM NAD 1983 (CONUS)
OREGON SOUTH ZONE 3602
US SURVEY FOOT
GRID NORTH

THE DYER PARTNERSHIP
ENGINEERS & PLANNERS, INC.
1330 Teakwood Avenue / Coos Bay, Oregon 97420
(541) 269-0732 / WWW.DYERPART.COM

Klein & Associates, Inc.
ENGINEERING•SURVEYING•PLANNING
1411 13th Street • Hood River, OR 97031
TEL: 541-386-3322 • FAX: 541-386-2515

PACIFIC CONNECTOR GAS PIPELINE PROJECT
PACIFIC CONNECTOR GAS PIPELINE, LP
RECORD OF SURVEY
TOWNSHIP 28 SOUTH, RANGE 7 WEST, W.M.
TOWNSHIP 29 SOUTH, RANGE 6 WEST, W.M.
DOUGLAS COUNTY, OREGON

Pacific Connector GAS PIPELINE

DRAWN BY: LJS	DATE: 09-23-2014	ISSUED FOR BID:	SCALE: 1" = 1000'
CHECKED BY:	DATE:	ISSUED FOR CONSTRUCTION:	
APPROVED BY:	DATE:	DRAWING NUMBER:	SHEET 1 OF 3

MAP FILE M166-23 A
REVISED SEE M166-37 A-C