

RECORD OF SURVEY

IN THE S 1/2 SEC. 8, SEC 16, AND SEC 17, T. 29 S. R. 6 W W.M.

DOUGLAS COUNTY, OREGON

FILED
 Date: 3-2-2016 By: JC
 This survey consists of:
 Map: M170-48A/B
 Nearest to:
 Corner to:

DOUGLAS COUNTY
 SURVEYOR

LEGEND:






- SET 5/8" I. ROD W/ RPC "SWEEDEN LS2752" () RECORD PER SURVEY M 101-72
- ⊕ FD. BRASS CAP UNLESS OTHERWISE NOTED ()R1 RECORD PER SURVEY M 146-58
- ⊙ FD. ALUM. CAP UNLESS OTHERWISE NOTED ()R2 RECORD PER SURVEY M 42-33
- FD. 5/8" I. ROD W/YPC "LAND MARK PLS 2287" ()R3 RECORD PER ORIGINAL DLC 43 FIELD NOTES
- UNLESS OTHERWISE NOTED ()R4 RECORD PER INST. # 2015-004739
- △ COMPUTED POINT ()R5 RECORD PER FIELD BOOK 64 PG. 35
- 5/8" I. ROD CRRW ()R6 RECORD PER 1973 CO. RD PLAN SHEETS 4-7
- ① CORNER NOTES, SEE SHEET 2 ()R7 RECORD PER 1992 BLM PLAT No. 6466
- ()R8 RECORD PER 1994 BLM PLAT No. 6569

CURVE TABLE:

CURVE	DELTA ANGLE	RADIUS	ARC TANGENT	CHORD	CHORD BEARING
C1	49°31'13"	477.46	412.66 220.21	399.94	S 42° 36' 55" W
C2	3°31'49"	442.46	27.26 13.64	27.26	S 19° 37' 13" W
C3	10°29'35"	666.62	122.08 61.21	121.91	S 22° 58' 36" W
C4	10°29'35"	636.62	116.59 58.46	116.43	S 22° 58' 36" W
C5	45°59'24"	442.46	355.15 187.77	345.69	N 44° 22' 49" E
C6	27°55'06"	358.10	174.49 89.01	172.77	S 47° 13' 15" W
C7	10°17'44"	328.10	58.96 29.56	58.88	S 56° 01' 57" W
C8	8°27'45"	388.10	57.32 28.71	57.27	S 37° 29' 35" W
C9	0°16'37"	388.10	1.88 0.94	1.88	N 41° 35' 08" E

SHORT LINE TABLE:

LINE	BEARING	DISTANCE
L1	N 2° 05' 20" E	933.77'
L2	N 2° 05' 20" E	358.44'
L3	N 88° 28' 56" W	527.53'
L4	S 88° 34' 21" E	788.92'
L5	S 1° 33' 54" E	994.19'
L6	S 88° 22' 49" E	309.32'
L7	S 88° 22' 49" E	826.05'

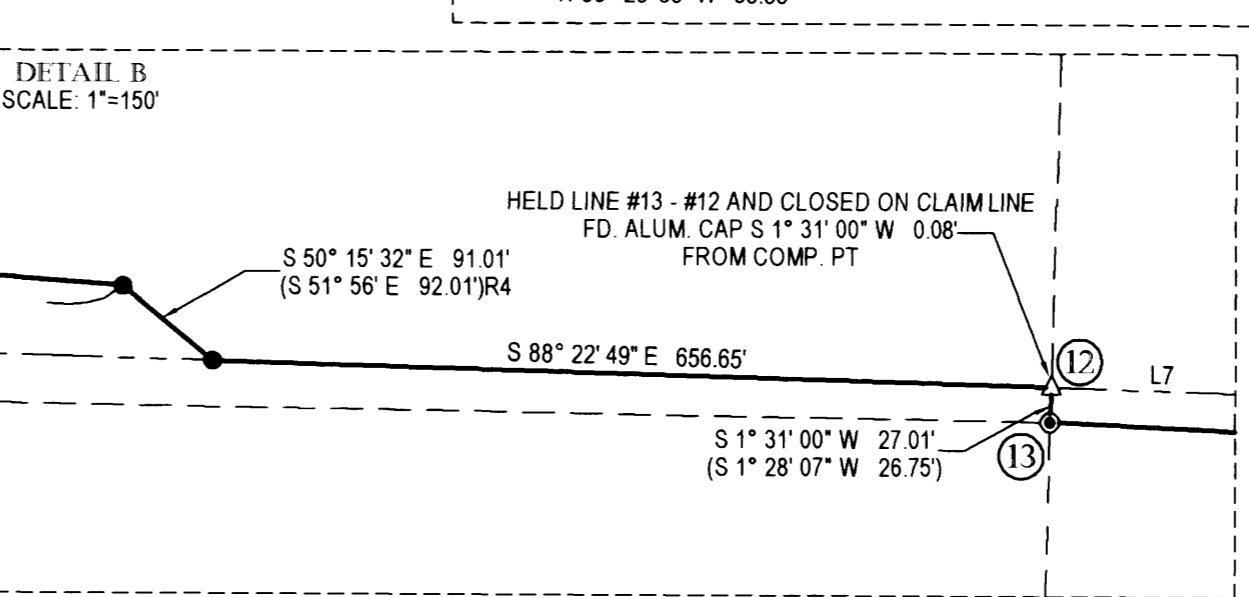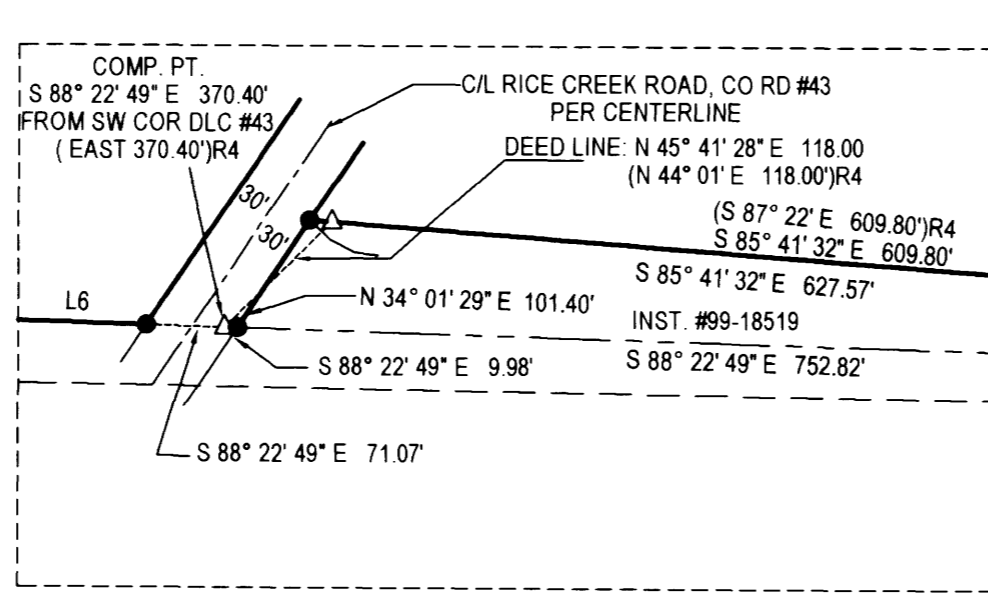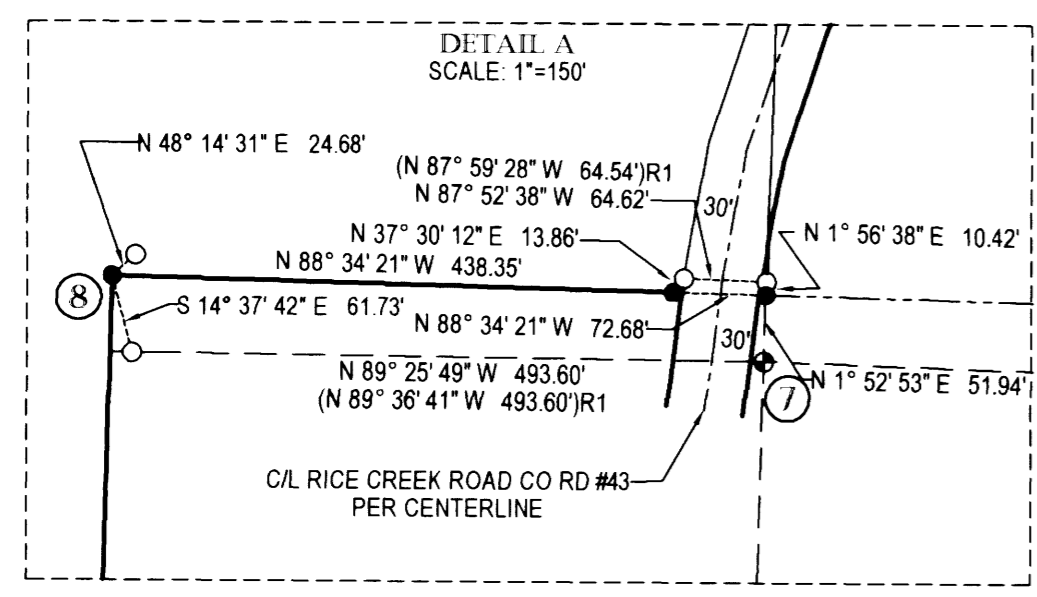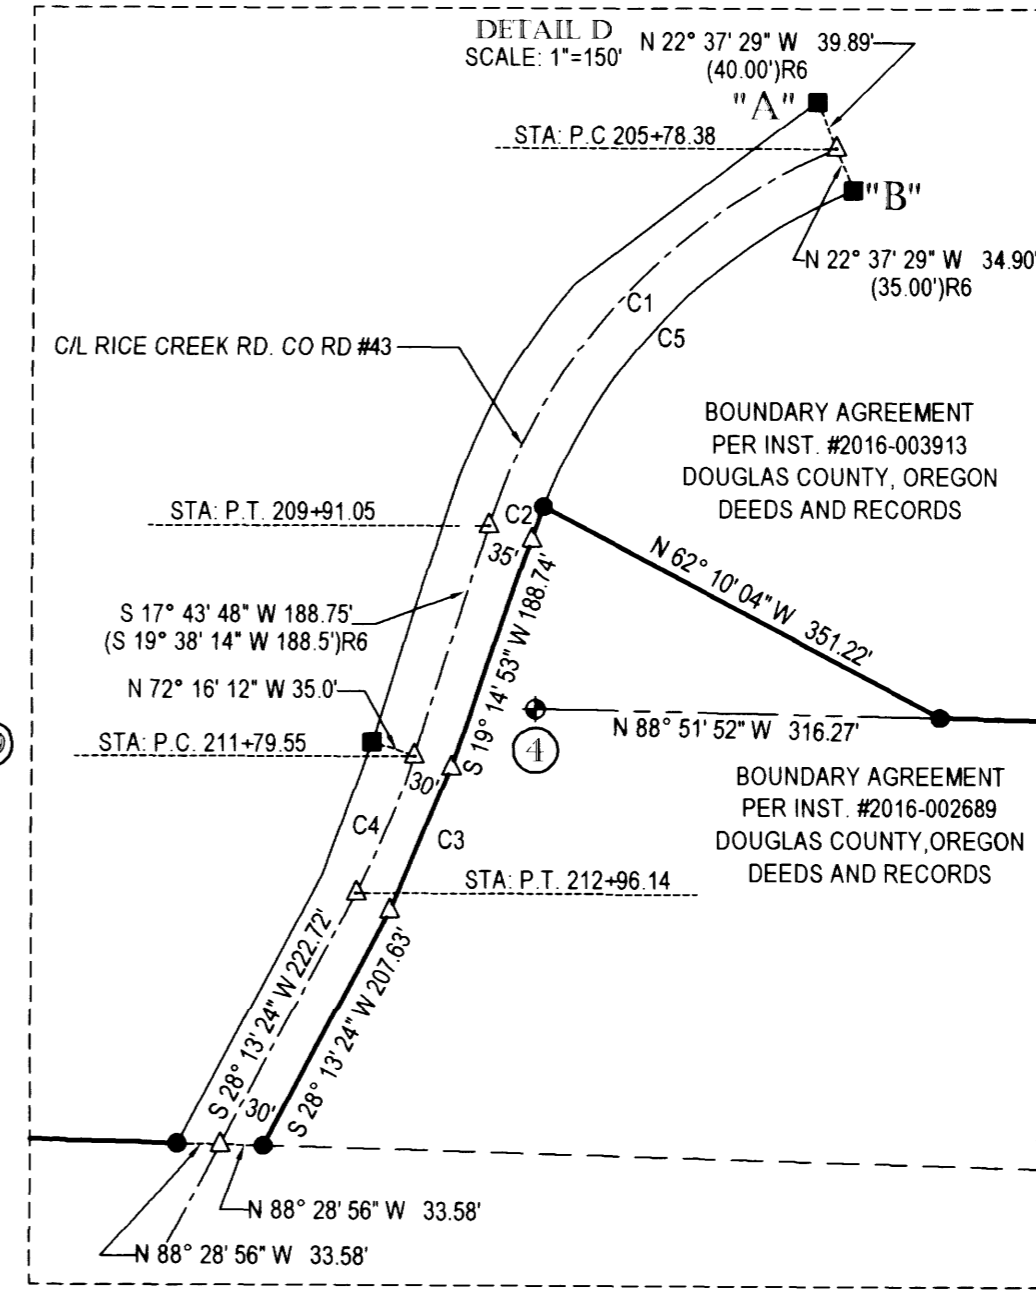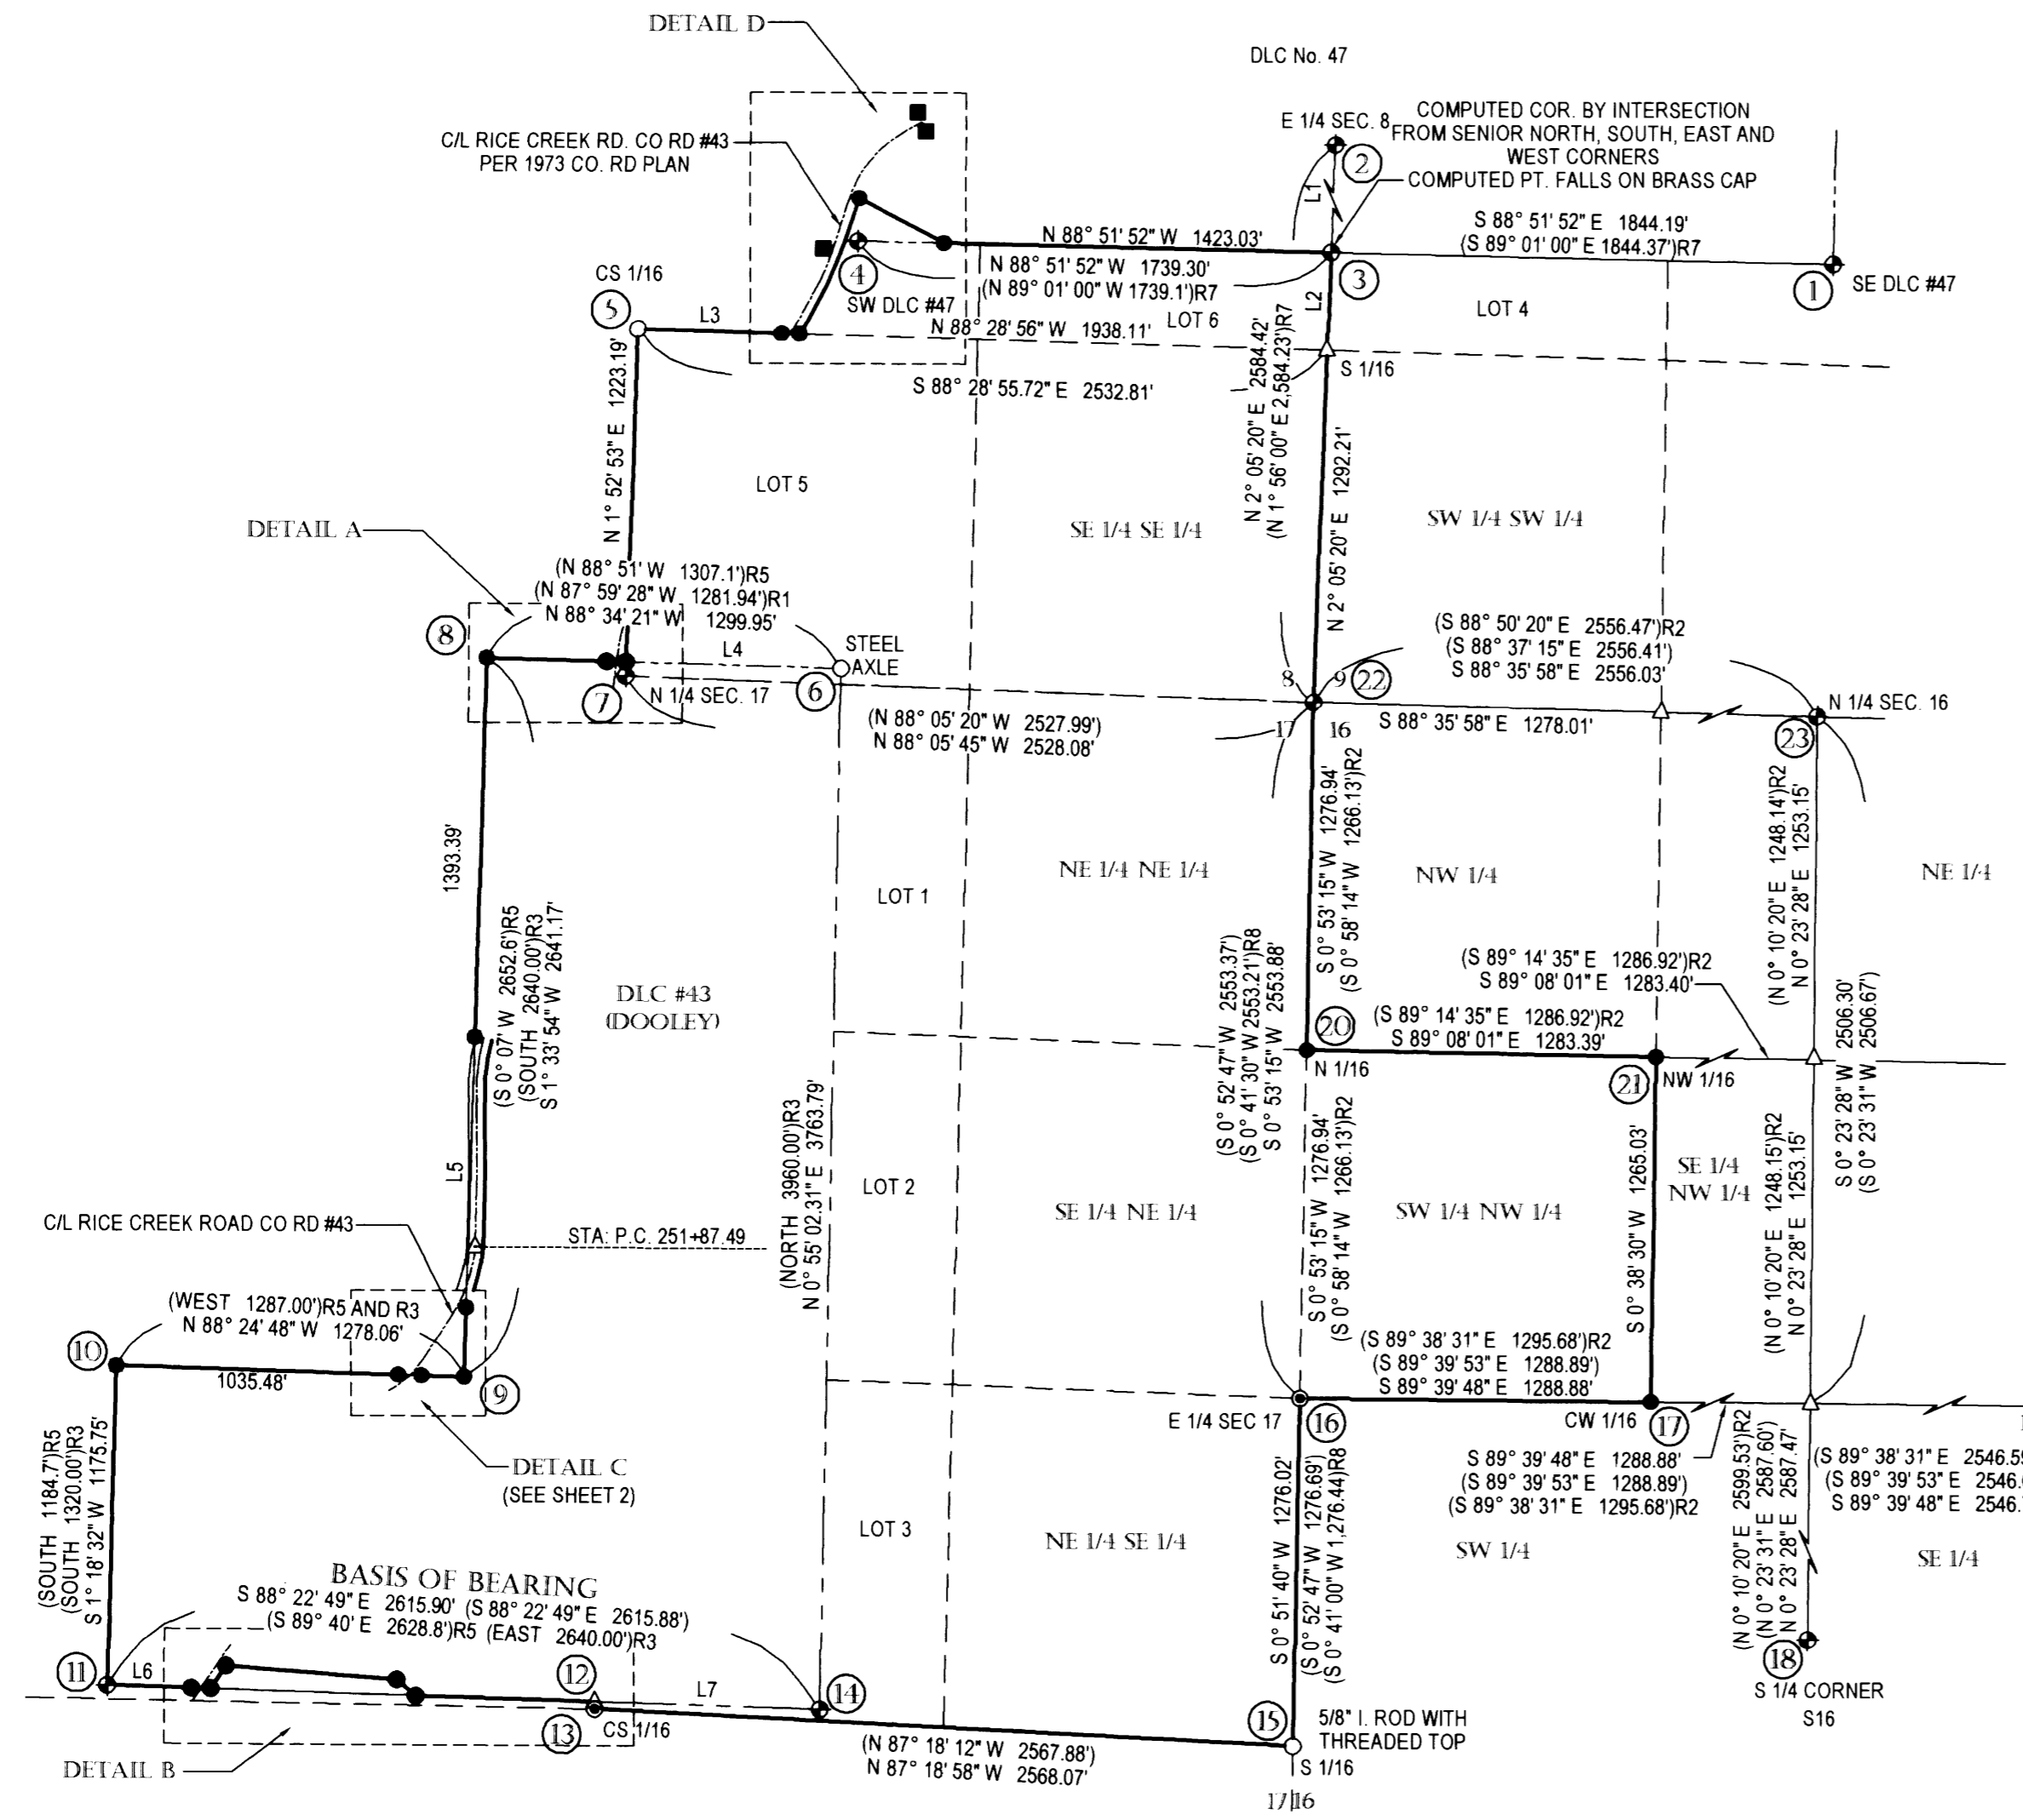

REGISTERED
 PROFESSIONAL
 LAND SURVEYOR

Carla Sweeden
 OREGON
 CARLA SWEEDEN
 2752
 JANUARY 16, 1996
 EXPIRES 6-30-16

Carl Sweeden Land Surveying LLC
 558 SE Jackson St. Roseburg, Oregon 97470
 Tel. 541-672-8344, Fax 541-672-1787

SURVEY FOR: HARRISON, RICE 47088 WESTFIR RD WESTFIR, OR 97492	FILE/JOB: Harrison, Rice.dwg DATE: JANUARY, 2016
SCALE: 1" = 600'	DRAWN BY: D. SWEEDEN SHEET: 1 OF 2