RECORD OF SURVEY

REEDSPORT SUBSTATION
LYING WITHIN
THE NE1/4NE1/4 OF SECTION 4 AND
THE NW1/4NW1/4 OF SECTION 3 T.22S., R.12W., W.M.
DOUGLAS COUNTY, OREGON

FILED
Date: 3-30-2016 By: JC
This survey consists of:
Map: M 170-54 A-E
Narrative:
Corner Rpt:
DOUGLAS COUNTY

MAP File No M170-54D

LEGEND

- FOUND MONUMENT NOTED IN TABLE (SHEET 3)
- SET MONUMENT AS NOTED IN TABLE (SHEET 3)
- CALCULATED POSITION, NO MONUMENT FOUND OR SET
- FOUND CONTROL NOTED IN TABLE (SHEET 3)
- FOREIGN POWER POLE
- FOREIGN GUY ANCHOR
- ( ) RECORD DATA PER REFERENCE LIST (SHEET 1)
- (XXX) MONUMENT NUMBER SEE SHEET 2
- BPA PROPERTY LINE
- RIGHT-OF-WAY LINE
- CENTERLINE
- BPA FENCE LINE
- FENCE LINE
- EDGE OF PAVEMENT
- PROPERTY LINE
- OP — OP FOREIGN OVERHEAD UTILITY LINES

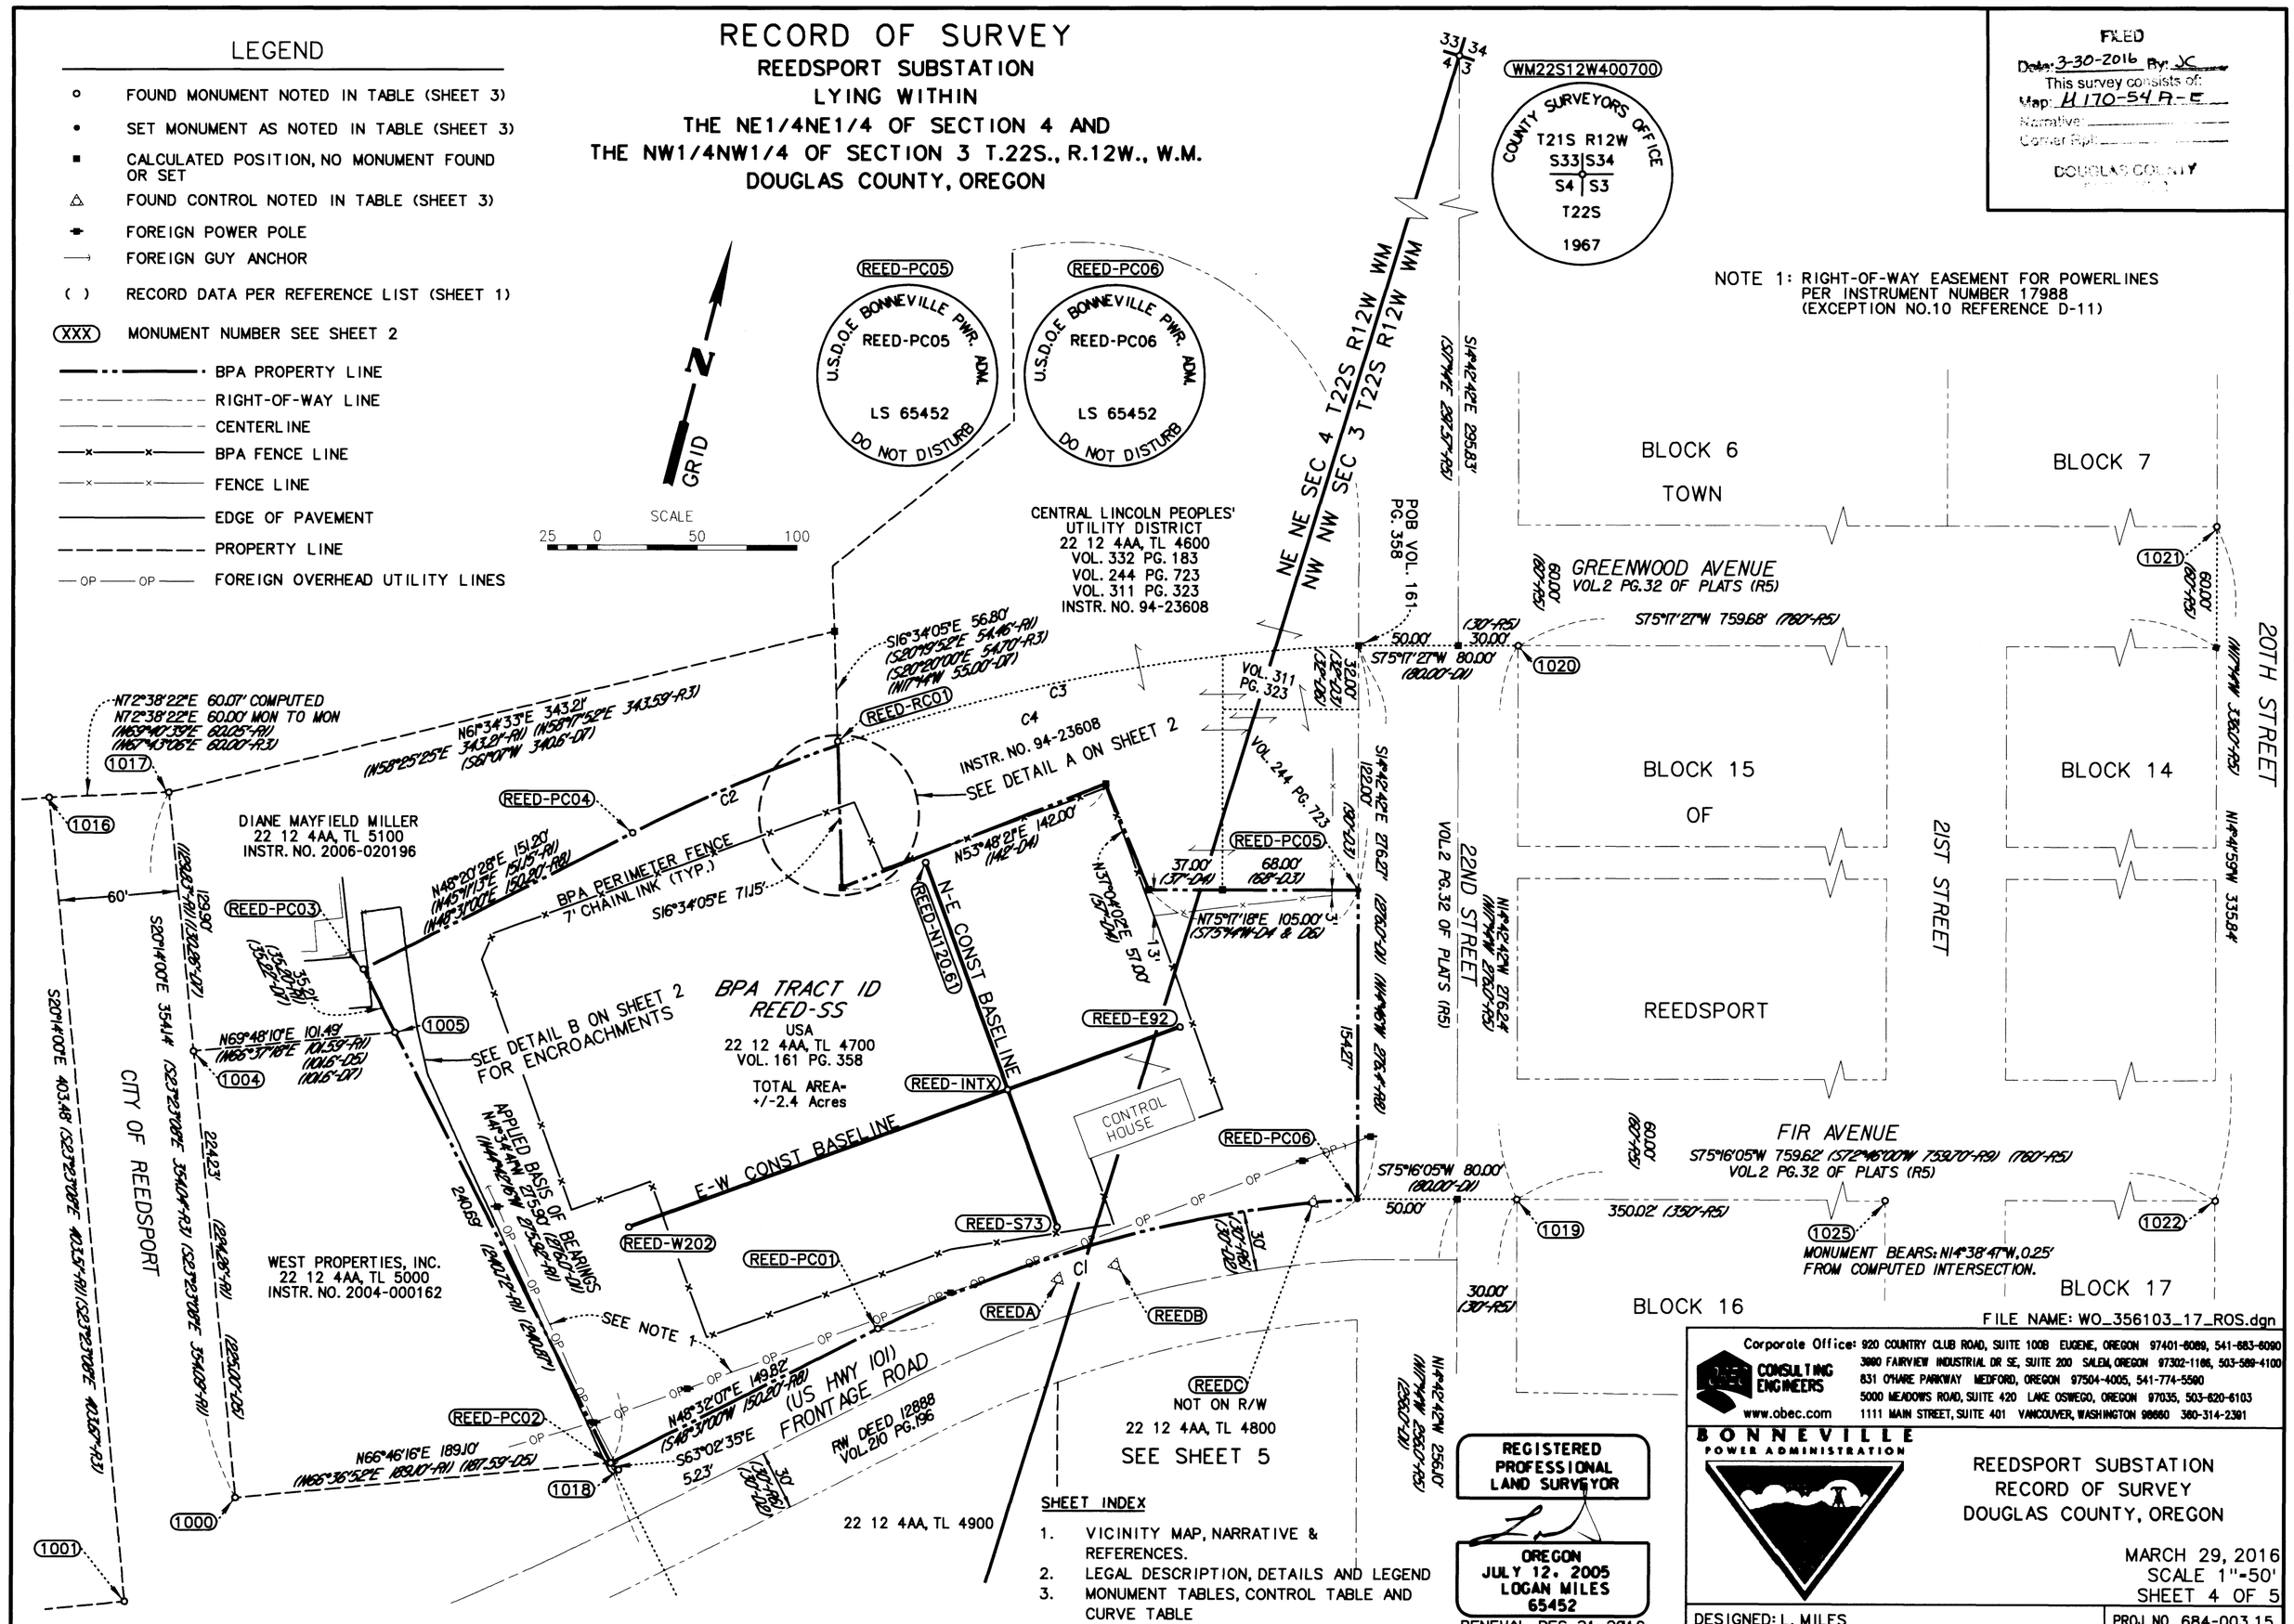

SHEET INDEX

1. VICINITY MAP, NARRATIVE & REFERENCES.
2. LEGAL DESCRIPTION, DETAILS AND LEGEND
3. MONUMENT TABLES, CONTROL TABLE AND CURVE TABLE
4.-5. SURVEY SHEETS

REGISTERED PROFESSIONAL LAND SURVEYOR
OREGON JULY 12, 2005 LOGAN MILES 65452
RENEWAL: DEC. 31, 2016
Signed: 3/29/16

FILE NAME: WO_356103_17_ROS.dgn

Corporate Office: 920 COUNTRY CLUB ROAD, SUITE 100B EUGENE, OREGON 97401-6089, 541-683-6090
3990 FAIRVIEW INDUSTRIAL DR SE, SUITE 200 SALEM, OREGON 97302-1166, 503-589-4100
831 O'HARE PARKWAY MEDFORD, OREGON 97504-4005, 541-774-5590
5000 MEADOWS ROAD, SUITE 420 LAKE OSWEGO, OREGON 97035, 503-620-6103
1111 MAIN STREET, SUITE 401 VANCOUVER, WASHINGTON 98660 360-314-2391
OBEC CONSULTING ENGINEERS www.obec.com
BONNEVILLE POWER ADMINISTRATION

REEDSPORT SUBSTATION
RECORD OF SURVEY
DOUGLAS COUNTY, OREGON

MARCH 29, 2016
SCALE 1"=50'
SHEET 4 OF 5

DESIGNED: L. MILES		PROJ. NO. 684-003.15
DRAWN: C.BARROWS	CHK'D: A. CUTSFORTH	W/O# 356103_17

MAP File No M170-54D