MAP FILE M171-66

RECORD OF SURVEY

LOCATED IN THE
NE 1/4 OF SECTION 15
TOWNSHIP 29 SOUTH, RANGE 9 WEST, W.M.
DOUGLAS COUNTY, OREGON

FILED
Date: 9-9-19 By: D
This survey consists of:
Map: M171-66
Narrative:
Corner Rpt:
DOUGLAS COUNTY SURVEYOR

NARRATIVE

THE PURPOSE OF THIS SURVEY IS TO AMEND THE SURVEY FILED AS COUNTY SURVEY NO. M171-16. THIS SURVEY SHOWS ADJUSTMENT MADE TO THE TEMPORARY EXTRA WORK SPACE IN THIS SECTION. NO MONUMENTS WERE SET PER THIS SURVEY.

REFERENCE SURVEYS:

1) BLM DEPENDENT RESURVEY NO. 7434 – AUGUST 18, 2010
2) ORIGINAL GLO PLAT JULY 1856
3) SURVEY M171-16

CORNER NOTES: (PER SURVEY M171-16)

(142786)
1/4 CORNER SECTIONS 14/15
FOUND 2" BRASS CAP
STAMPED COUNTY SURVEYOR'S OFFICE 1974
BT REFERENCES:
1) 11-1/2" FIR WITH HEALED FACE
AND ROSEBURG RESOURCES TAG DATED 9/04
N 2-1/2° E - 35.2' TO NAIL IN SIDE CENTER
2) 19.5" FIR WITH
ROSEBURG RESOURCE TAG DATED 9/04
S 56° E - 33.7' TO NAIL IN SIDE CENTER
3) 30" DIA. 22 FT. TALL SNAG WITH HEALED FACE
AND BLM TAG DATED 9/59
S 3-1/2° E - 30.6'
4) 11.5" FIR WITH HEALED FACE
AND ROSEBURG RESOURCES TAG DATED 9/04
S 80-1/2° W - 48.2' TO NAIL IN SIDE CENTER
5) 28" FIR WITH HEALED FACE
AND ROSEBURG RESOURCES TAG DATED 9/04
N 63-1/2° W - 44.2' TO NAIL IN SIDE CENTER

(142791)
SOUTH 1/4 CORNER SECTION 10
FOUND 2-1/2" BRASS CAP
STAMPED COUNTY SURVEYOR'S OFFICE 1959
BT REFERENCES:
1) 13" WHITE FIR WITH HEALED FACE
WITH TAG DATED 01/01
N 55° E – 9.1' TO NAIL IN SIDE CENTER

(148083)
NORTHEAST CORNER SECTION 15
FOUND 2-1/2" BRASS CAP
STAMPED COUNTY SURVEYOR 1959
STAMPED BLM 1966
BT REFERENCES:
1) 47" FIR WITH HEALED FACE
AND ROSEBURG RESOURCES TAG DATED 09-04
N 08° E – 33.8' TO NAIL IN SIDE CENTER
2) 23-1/2" FIR WITH HEALED FACE
AND ROSEBURG RESOURCES TAG DATED 9/04
N 50° E – 11.8' TO NAIL IN SIDE CENTER
3) 37" FIR WITH HEALED FACE
AND ROSEBURG RESOURCES TAG DATED 9/04
S 44-1/2° E – 21.1' TO NAIL IN SIDE CENTER
4) 16" FIR WITH HEALED FACE
AND ROSEBURG RESOURCES TAG DATED 09/04
S 36-1/2° W – 3.5' TO NAIL IN SIDE CENTER
5) 12" FIR WITH HEALED FACE
AND ROSEBURG RESOURCES TAG DATED 09-04
N 55° W – 14.8' TO NAIL IN SIDE CENTER

(148105)
NORTH 1/4 CORNER SECTION 15
FOUND 3-1/4" ALUMINUM CAP
STAMPED BLM 2005
BT REFERENCES:
1) 13" HEMLOCK WITH VISIBLE SCRIBE
AND BLM TAG DATED 09/05
S 58 1/4° E – 5.0' TO NAIL IN SIDE CENTER
2) 7" HEMLOCK WITH VISIBLE SCRIBE
AND BLM TAG DATED 09/05
S 27 1/2° W – 6.7' TO NAIL IN SIDE CENTER

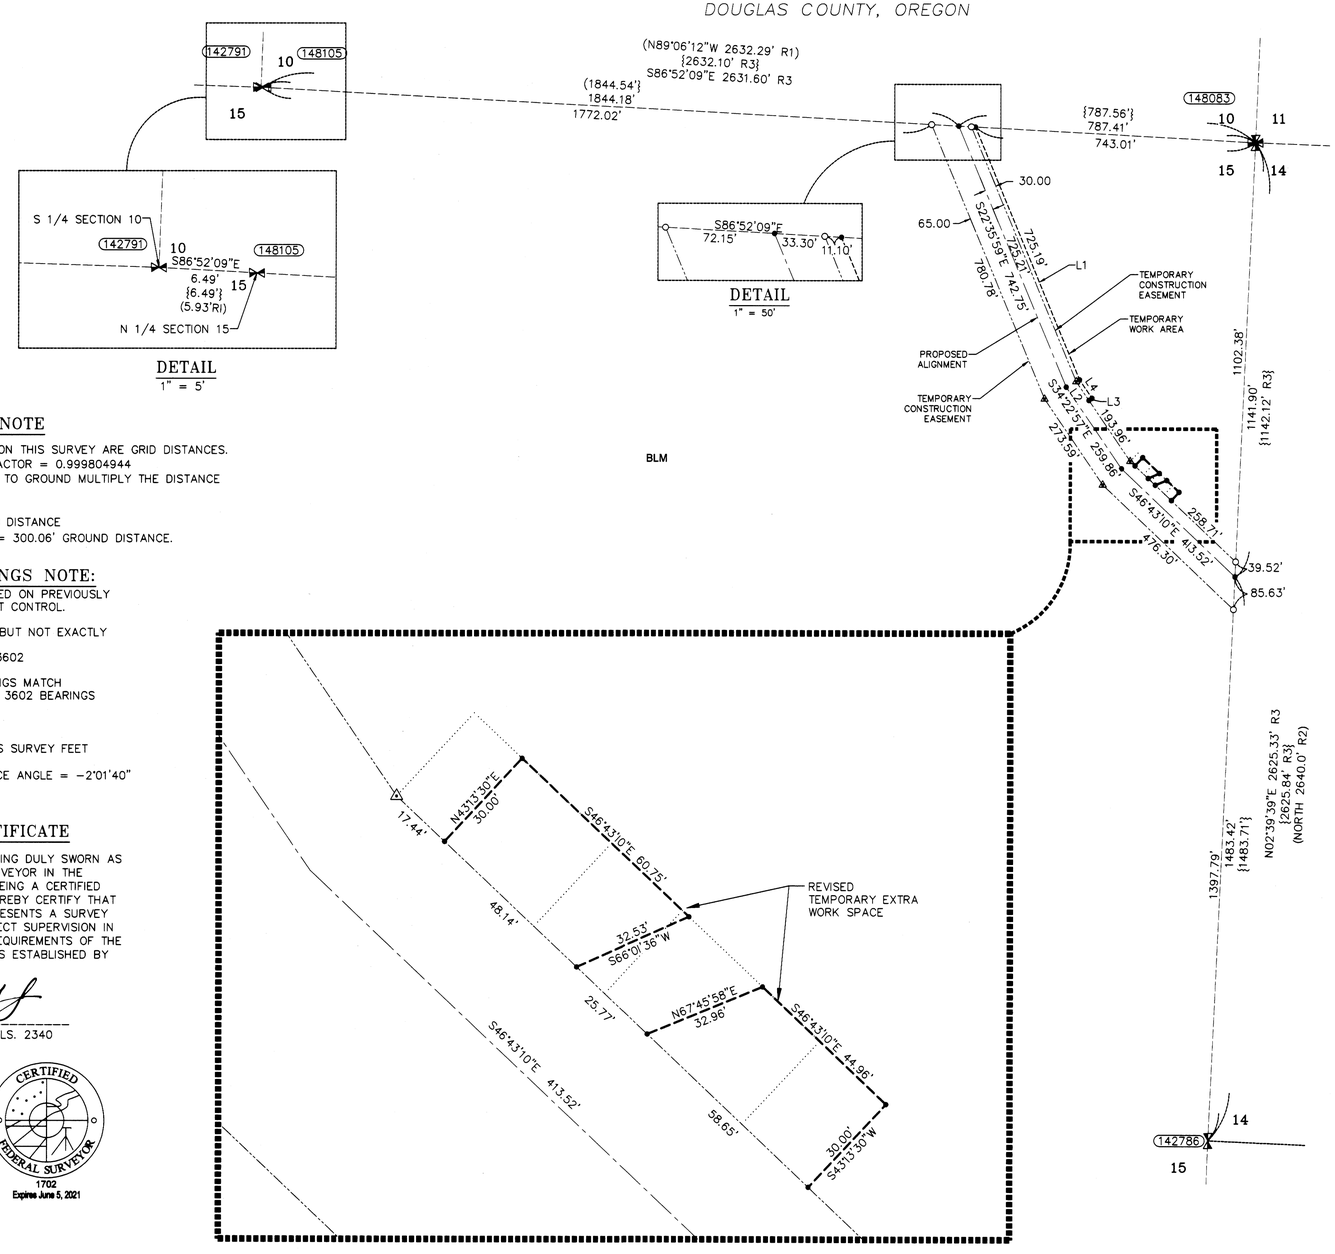

DETAIL
1" = 5'

DETAIL
1" = 50'

DETAIL
1" = 20'

N

200 0 200 400
SCALE – FEET

LINE TABLE		
Line #	Direction	Length
L1	S22°35'59"E	719.34'
L2	S34°22'57"E	59.56'
L3	S55°37'03"W	10.00'
L4	S34°22'57"E	58.53'

SCALE FACTOR NOTE

THE DISTANCES SHOWN ON THIS SURVEY ARE GRID DISTANCES.
THE COMBINED SCALE FACTOR = 0.999804944
TO CONVERT FROM GRID TO GROUND MULTIPLY THE DISTANCE BY 1.000195094.

EXAMPLE: 300.00' GRID DISTANCE
300.00' x 1.000195094 = 300.06' GROUND DISTANCE.

BASIS OF BEARINGS NOTE:

THE PROJECT DATUM IS BASED ON PREVIOUSLY ESTABLISHED PROJECT CONTROL.

THE DATUM IS VERY CLOSE BUT NOT EXACTLY
OREGON
SOUTH ZONE 3602

THE PROJECT BEARINGS MATCH
THE OREGON SOUTH ZONE 3602 BEARINGS

NOTE:

DISTANCES ARE IN US SURVEY FEET

MEAN MERIDIAN CONVERGENCE ANGLE = –2°01'40"

SURVEYOR'S CERTIFICATE

I, MICHAEL W. ERICKSON BEING DULY SWORN AS A PROFESSIONAL LAND SURVEYOR IN THE STATE OF OREGON, ALSO BEING A CERTIFIED FEDERAL SURVEYOR, DO HEREBY CERTIFY THAT THIS MAP CORRECTLY REPRESENTS A SURVEY CONDUCTED UNDER MY DIRECT SUPERVISION IN CONFORMANCE WITH THE REQUIREMENTS OF THE SURVEY RECORDING LAW, AS ESTABLISHED BY ORS CHAPTER 209.

MICHAEL W. ERICKSON PLS. 2340

REGISTERED PROFESSIONAL LAND SURVEYOR
OREGON JULY 26, 1988
MICHAEL W. ERICKSON 2340
Expires 12-31-2019

CERTIFIED FEDERAL SURVEYOR
1702
Expires June 5, 2021

LEGEND

- ⊙ FOUND MONUMENT AS NOTED (SEE CORNER NOTES)
- • COMPUTED POINT, NOT MONUMENTED
- △ 5/8" X 24" REBAR WITH 1 1/4" YELLOW PLASTIC CAP (KITZ 1853LS) RECORD PER SURVEY NO. M171-16
- ○ 5/8" X 24" REBAR WITH 1 1/4" YELLOW PLASTIC CAP (KLEIN & ASSOC. LS 59002) RECORD PER SURVEY NO. M171-16
- QUARTER CORNER. RECORD PER SURVEY NO. 171-16
- FOUND SECTION CORNER. RECORD PER SURVEY NO. 171-16
- COMPUTED QUARTER CORNER
- COMPUTED SECTION CORNER
- (100000) POINT NUMBER
- {xxx.xx'} GROUND DISTANCE
- (xxx.xx') RECORD DISTANCE PER REFERENCED SURVEY
- R1 REFERENCED SURVEY
- PROPOSED ALIGNMENT
- TEMPORARY CONSTRUCTION EASEMENT
- TEMPORARY WORK AREA
- LINE PER MAP OF SURVEY NO. M166-18

WILLAMETTE MERIDIAN
DOUGLAS COUNTY, OREGON

T.29S., R.09W

15

SURVEY PERFORMED FOR:
ENSITE USA
DATE OF SURVEY: 03/25/2019
PROJECT: 900.127 DRAFT: RAA
FILE: RS-29S-R09WB

THE DYER PARTNERSHIP
ENGINEERS & PLANNERS, INC.
1330 Teakwood Avenue / Coos Bay, Oregon 97420
(541) 269-0732 / WWW.DYERPART.COM

PACIFIC CONNECTOR GAS PIPELINE PROJECT
PACIFIC CONNECTOR GAS PIPELINE, LP
SECTION 15
RECORD OF SURVEY
TOWNSHIP 29 SOUTH, RANGE 9 WEST, W.M.
DOUGLAS COUNTY, OREGON

Pacific Connector GAS PIPELINE

DRAWN BY: RAA	DATE: 04-30-2019	ISSUED FOR BID:	SCALE: 1" = 200'
CHECKED BY:	DATE:	ISSUED FOR CONSTRUCTION:	
APPROVED BY:	DATE:	DRAWING NUMBER:	SHEET 1 OF 1

MAP FILE M171-66