


REUBEN - McCLOUGH COUNTY RD.
COUNTY RD. NO. 27
60' RW

- LEGEND:**
- FOUND AS NOTED
 - CALCULATED POINT, NOTHING FOUND OR SET
 - SET 5/8" IRON ROD WITH PLASTIC CAP INSCRIBED "LAND MARK SURVEYING, INC"

- RECORD INFORMATION:**
- () R1 RECORD DATA PER INSTRUMENT NUMBER 2018-4835 AND VOLUME 70, PAGE 236
 - () R2 RECORD DATA PER VOLUME 70, PAGE 236
 - () R3 RECORD DATA PER VOLUME 80, PAGE 621
 - () R4 RECORD DATA PER M49-21
 - () R5 RECORD DATA PER GLO PLAT T32S, R6W, W.M., DATED MARCH 31, 1856
 - () R6 RECORD DATA PER GLO PLAT T33S, R6W, W.M., DATED MARCH 31, 1856

BASIS OF BEARINGS:
OREGON COORDINATE REFERENCE SYSTEM (OCRS)
CANYONVILLE - GRANTS PASS ZONE
NAD 83 (2011) EPOCH 2010.00

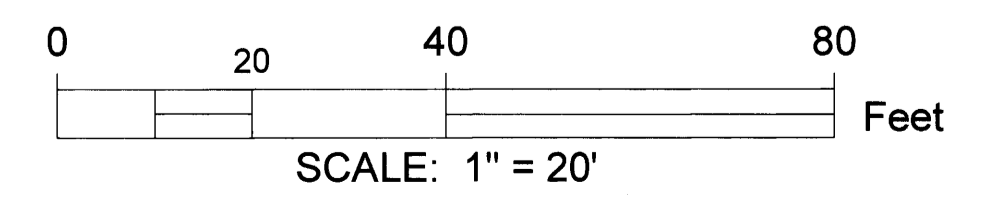

Sheet 2 of 2

Record of Survey
In the SW 1/4, Section 33
Township 32 South, Range 6 West, W.M.
Douglas County, Oregon
December 5, 2023

FOR: LARRY OTTING
364 REUBEN ROAD
GLENDALE, OR 97442

REGISTERED PROFESSIONAL LAND SURVEYOR
Barton M. Heichel
OREGON
AUGUST 17, 2009
BARTON M. HEICHEL
1640PLS
RENEWS JUNE 30, 2025

LM Land Mark
Surveying, Inc.
P.O. Box 13 • Roseburg, Oregon 97470
Office (541) 677-9400 • Cell (541) 637-6999
LM Prof. No. 2023-0064