RECORD OF SURVEY

LOCATED IN
THE NE 1/4 OF SECTION 11
AND THE NW 1/4 SECTION 12
T27S, R6W, W.M.
DOUGLAS COUNTY, OREGON

FILED
Date: 3-2-2022 By: DG
This Survey Consists of:
Map: M180-52 A&B
Narrative:
Corner Rpt.:
DOUGLAS COUNTY SURVEYOR

MAP FILE M180-52 B

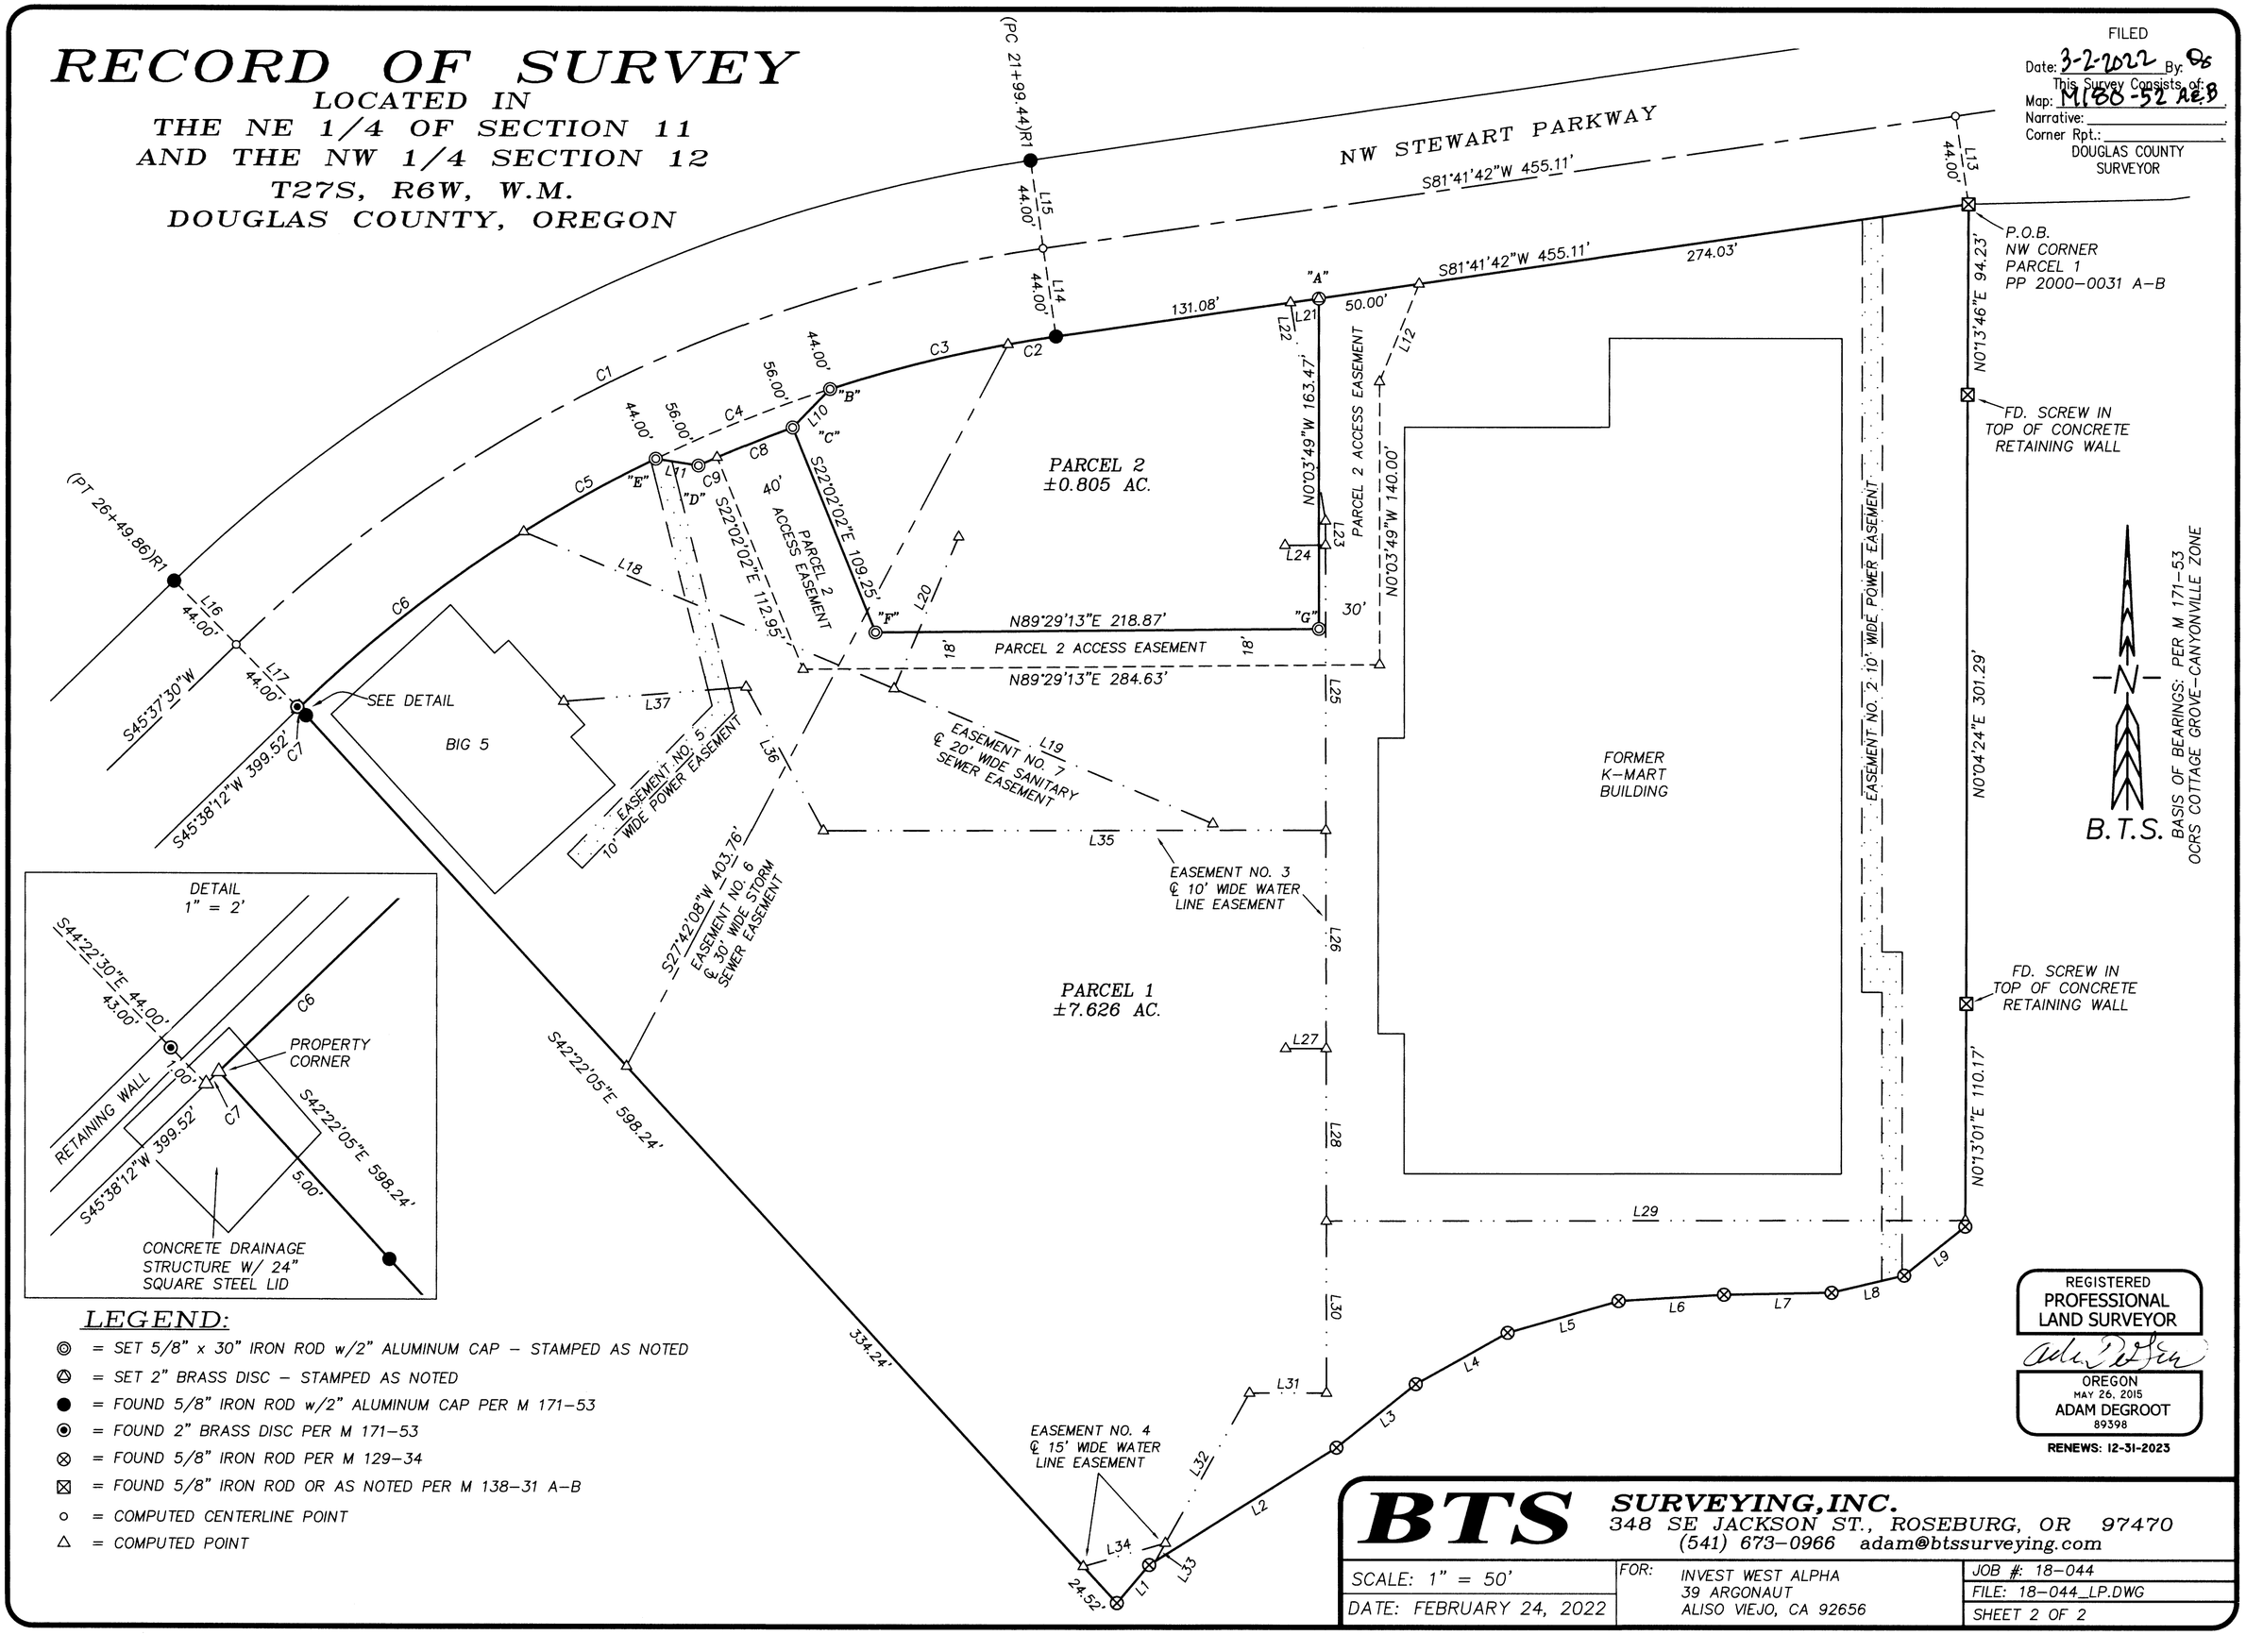

LEGEND:

- ◎ = SET 5/8" x 30" IRON ROD w/2" ALUMINUM CAP – STAMPED AS NOTED
- ⊙ = SET 2" BRASS DISC – STAMPED AS NOTED
- ● = FOUND 5/8" IRON ROD w/2" ALUMINUM CAP PER M 171-53
- ⊙ = FOUND 2" BRASS DISC PER M 171-53
- ⊗ = FOUND 5/8" IRON ROD PER M 129-34
- ⊠ = FOUND 5/8" IRON ROD OR AS NOTED PER M 138-31 A-B
- ○ = COMPUTED CENTERLINE POINT
- △ = COMPUTED POINT

REGISTERED
PROFESSIONAL LAND SURVEYOR
OREGON
MAY 26, 2015
ADAM DEGROOT
89398
RENEWS: 12-31-2023

BTS SURVEYING, INC.
348 SE JACKSON ST., ROSEBURG, OR 97470
(541) 673-0966 adam@btssurveying.com

SCALE: 1" = 50'	FOR: INVEST WEST ALPHA 39 ARGONAUT ALISO VIEJO, CA 92656	JOB #: 18-044
DATE: FEBRUARY 24, 2022		FILE: 18-044_LP.DWG
		SHEET 2 OF 2

MAP FILE M180-52 B