SEC 3&4 T23S R5W W.M.

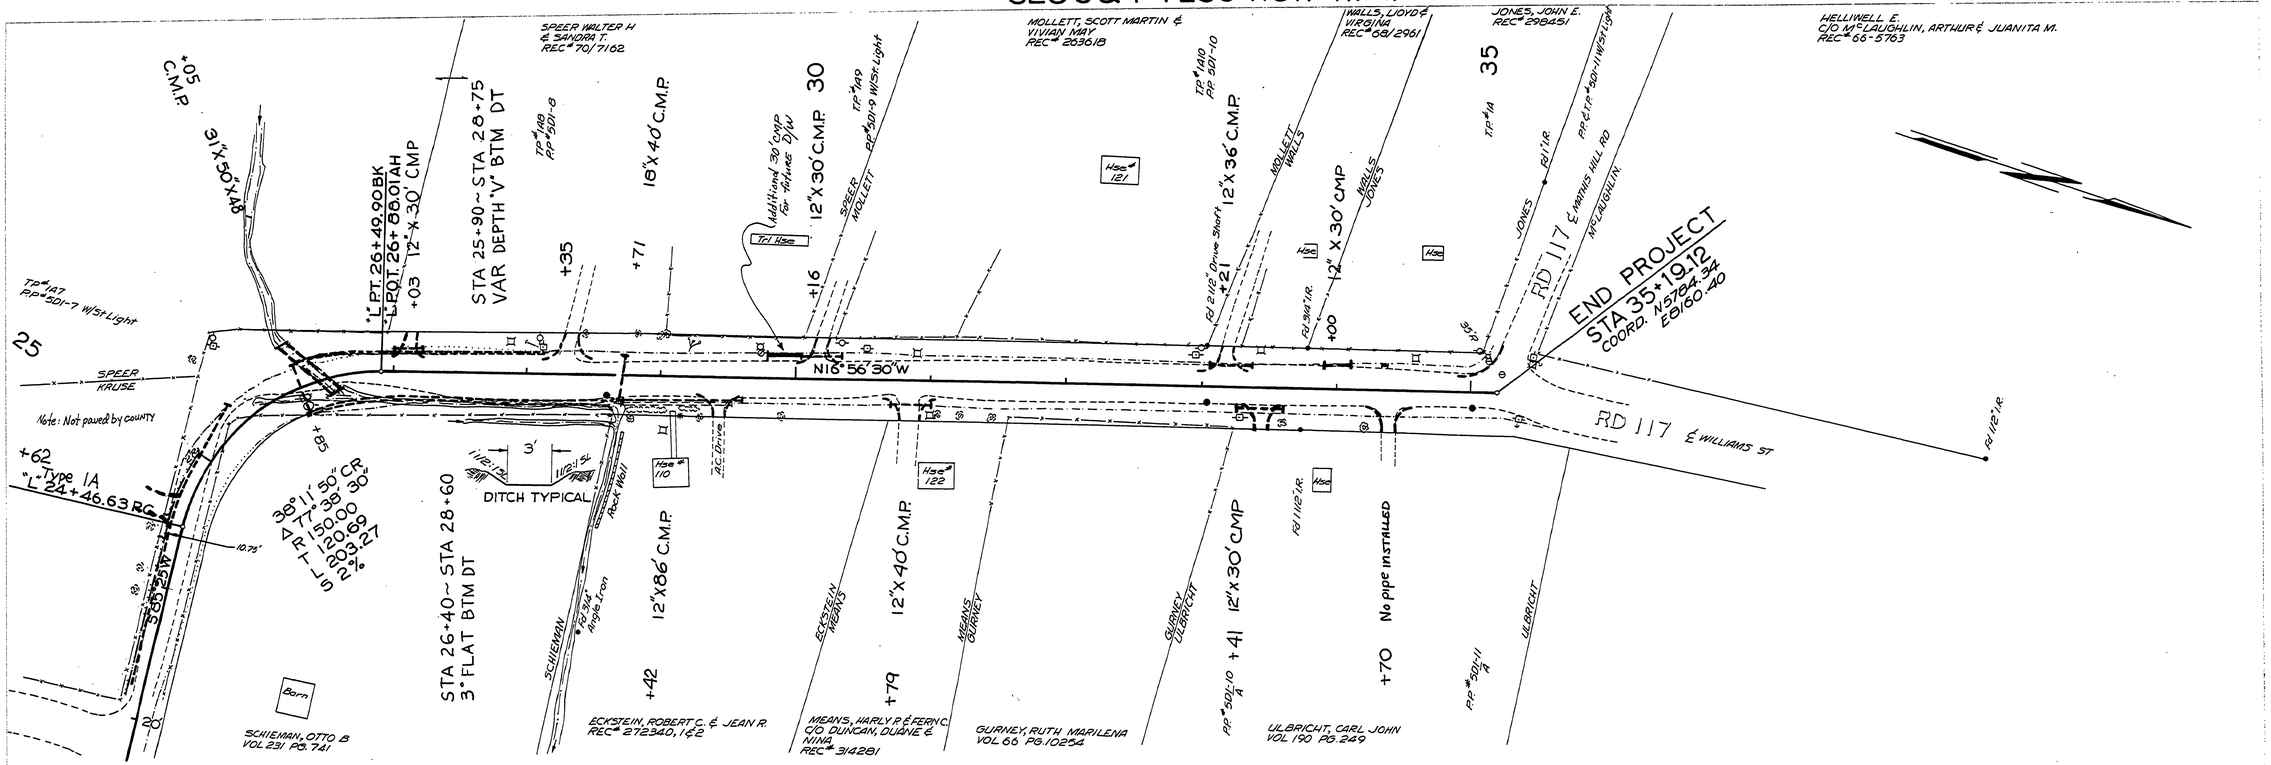

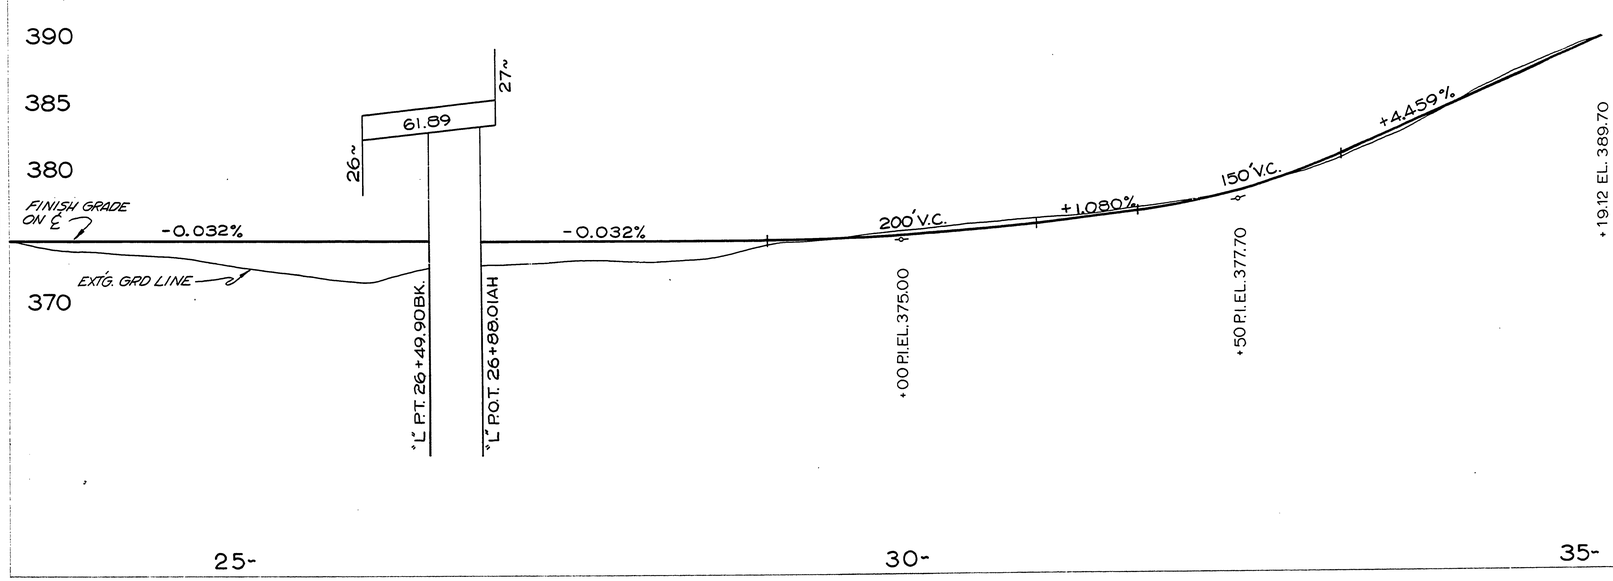

AS CONSTRUCTED B.B.B.

DOUGLAS COUNTY ROAD DEPT.
FIRST ST. — YONCALLA
MAY 1971 SHT 5
GEORGE E. GRUBB COUNTY ENG