


N
N
N

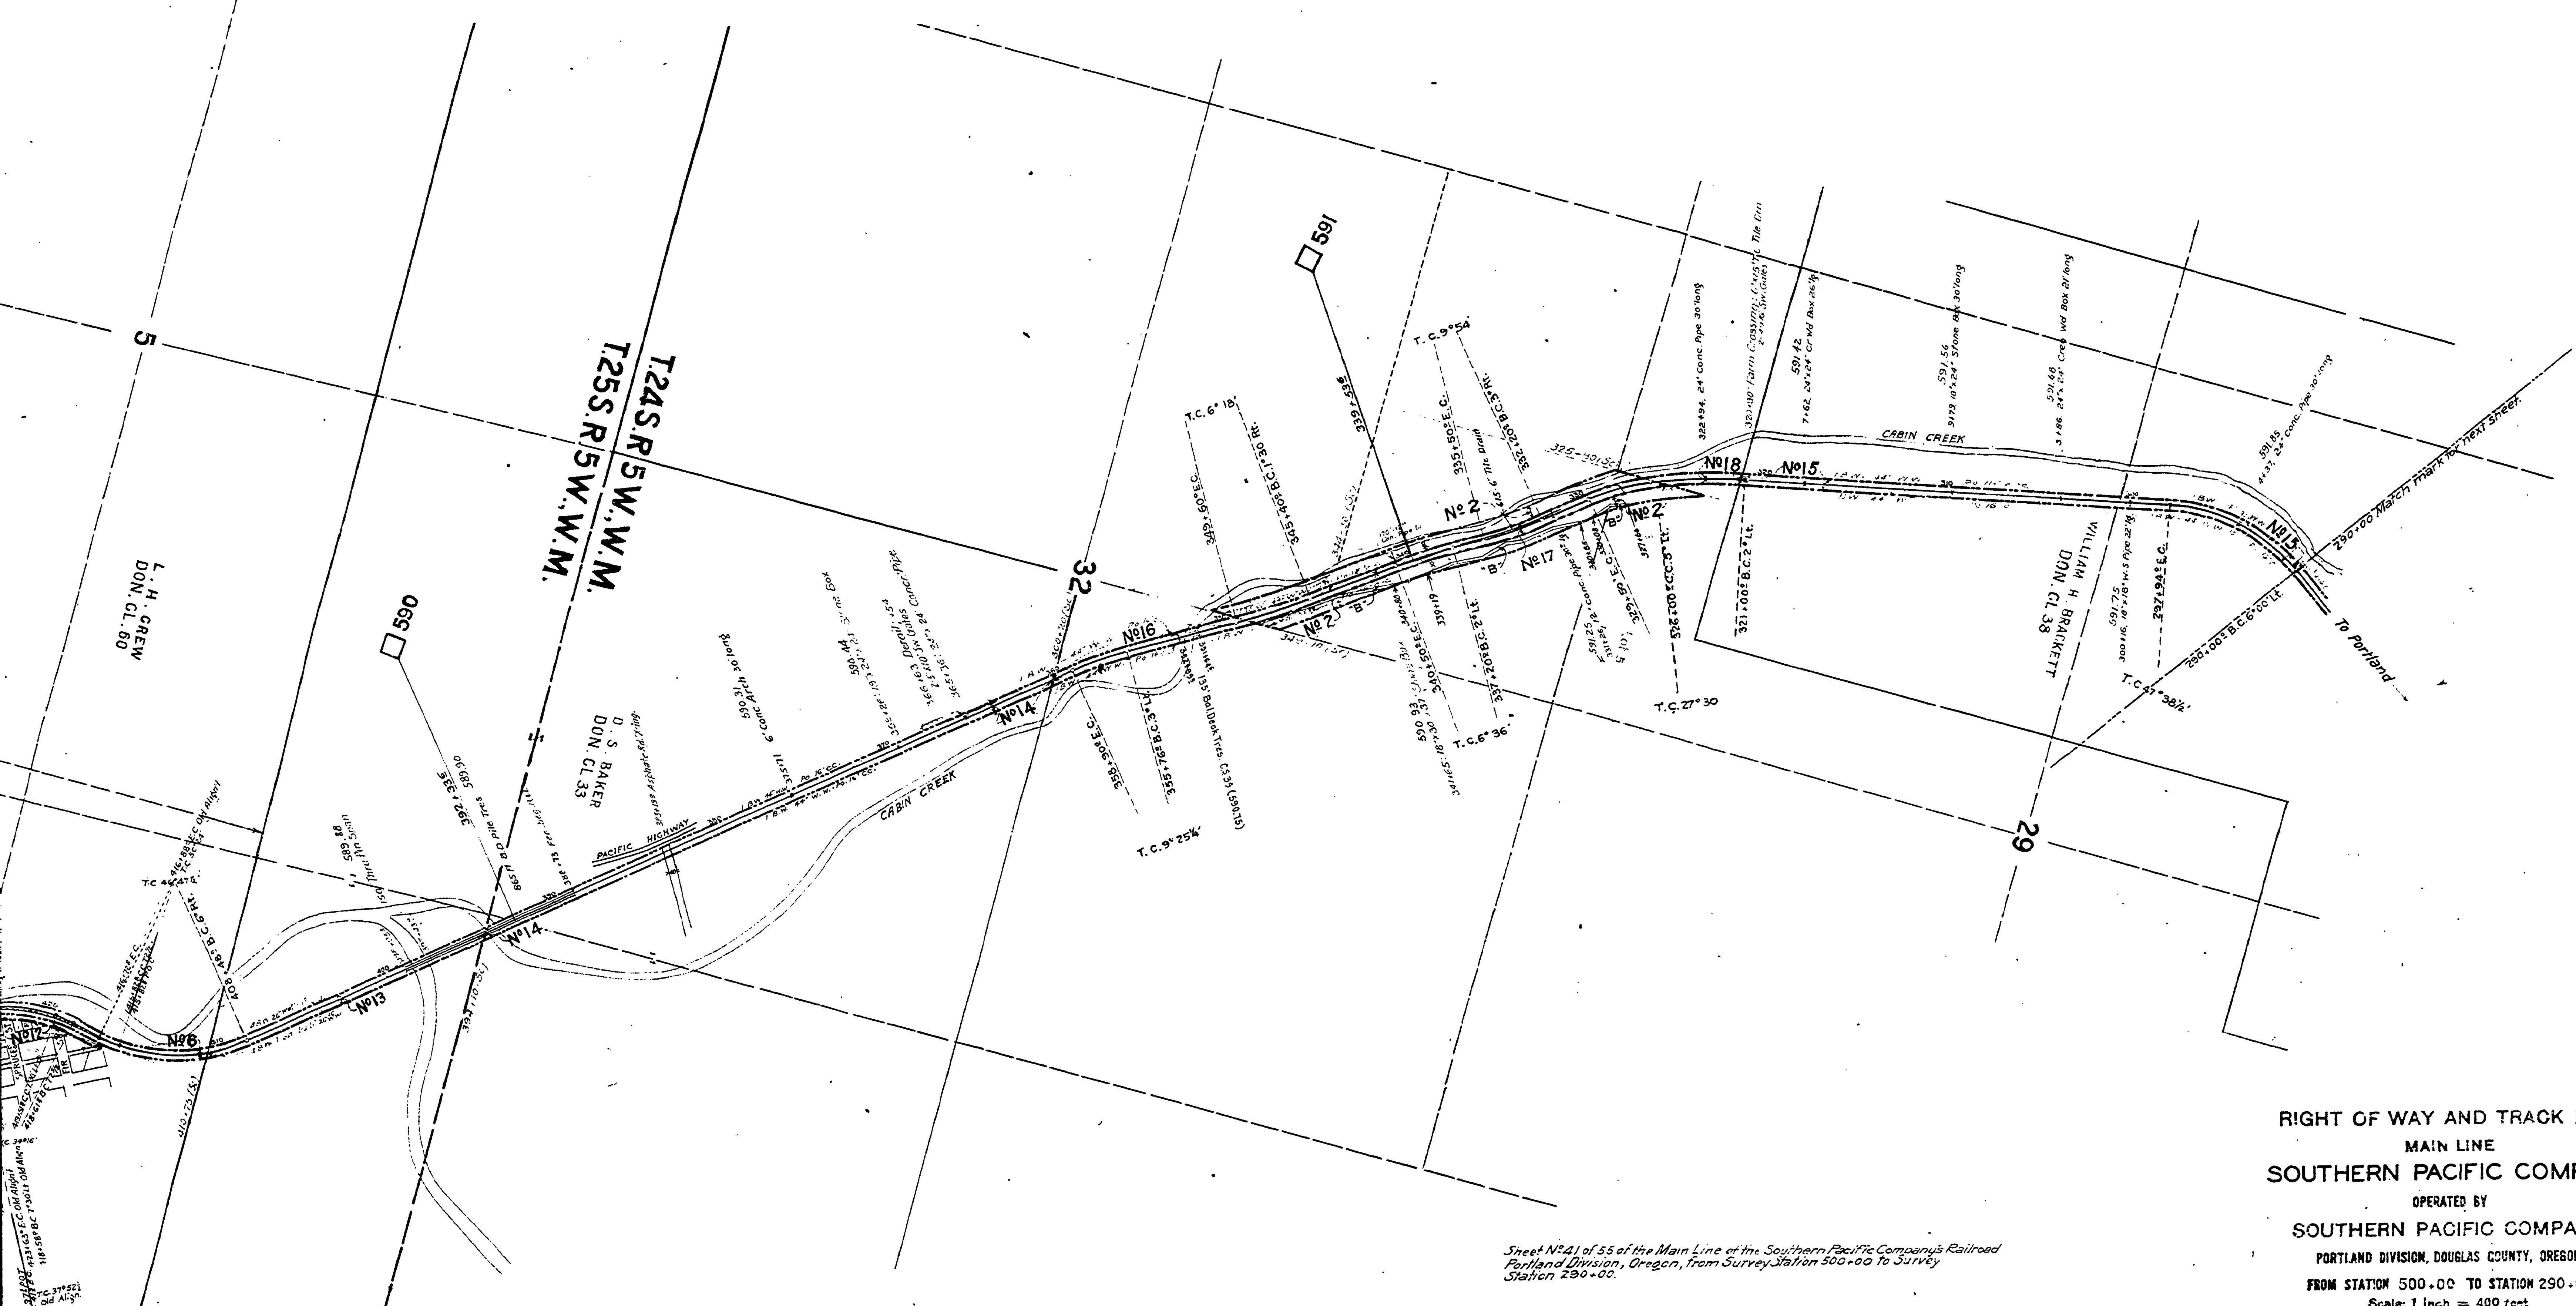

L. H. CREW
DON. CL. 60

T24S.R5W.W.M.
T25S.R5W.W.M.

D. S. BAKER
DON. CL. 33

WILLIAM H. BRACKETT
DON. CL. 38

RIGHT OF WAY AND TRACK MAP
 MAIN LINE
 SOUTHERN PACIFIC COMPANY
 OPERATED BY
 SOUTHERN PACIFIC COMPANY
 PORTLAND DIVISION, DOUGLAS COUNTY, OREGON
 FROM STATION 500+00 TO STATION 290+00
 Scale: 1 inch = 400 feet
 VALUATION DEPARTMENT
 SAN FRANCISCO, CALIFORNIA

Sheet No. 41 of 55 of the Main Line of the Southern Pacific Company's Railroad
 Portland Division, Oregon, From Survey Station 500+00 To Survey
 Station 290+00.

Valuation Officer

V16
41

33

29

32

5

590

591

590
589
588