Note No.1: 60.396 Acs. acqd; 6.351 Acs. same as and incl. in Par. 1a, 1.931 acs. same as and incl. in Par. 1b.

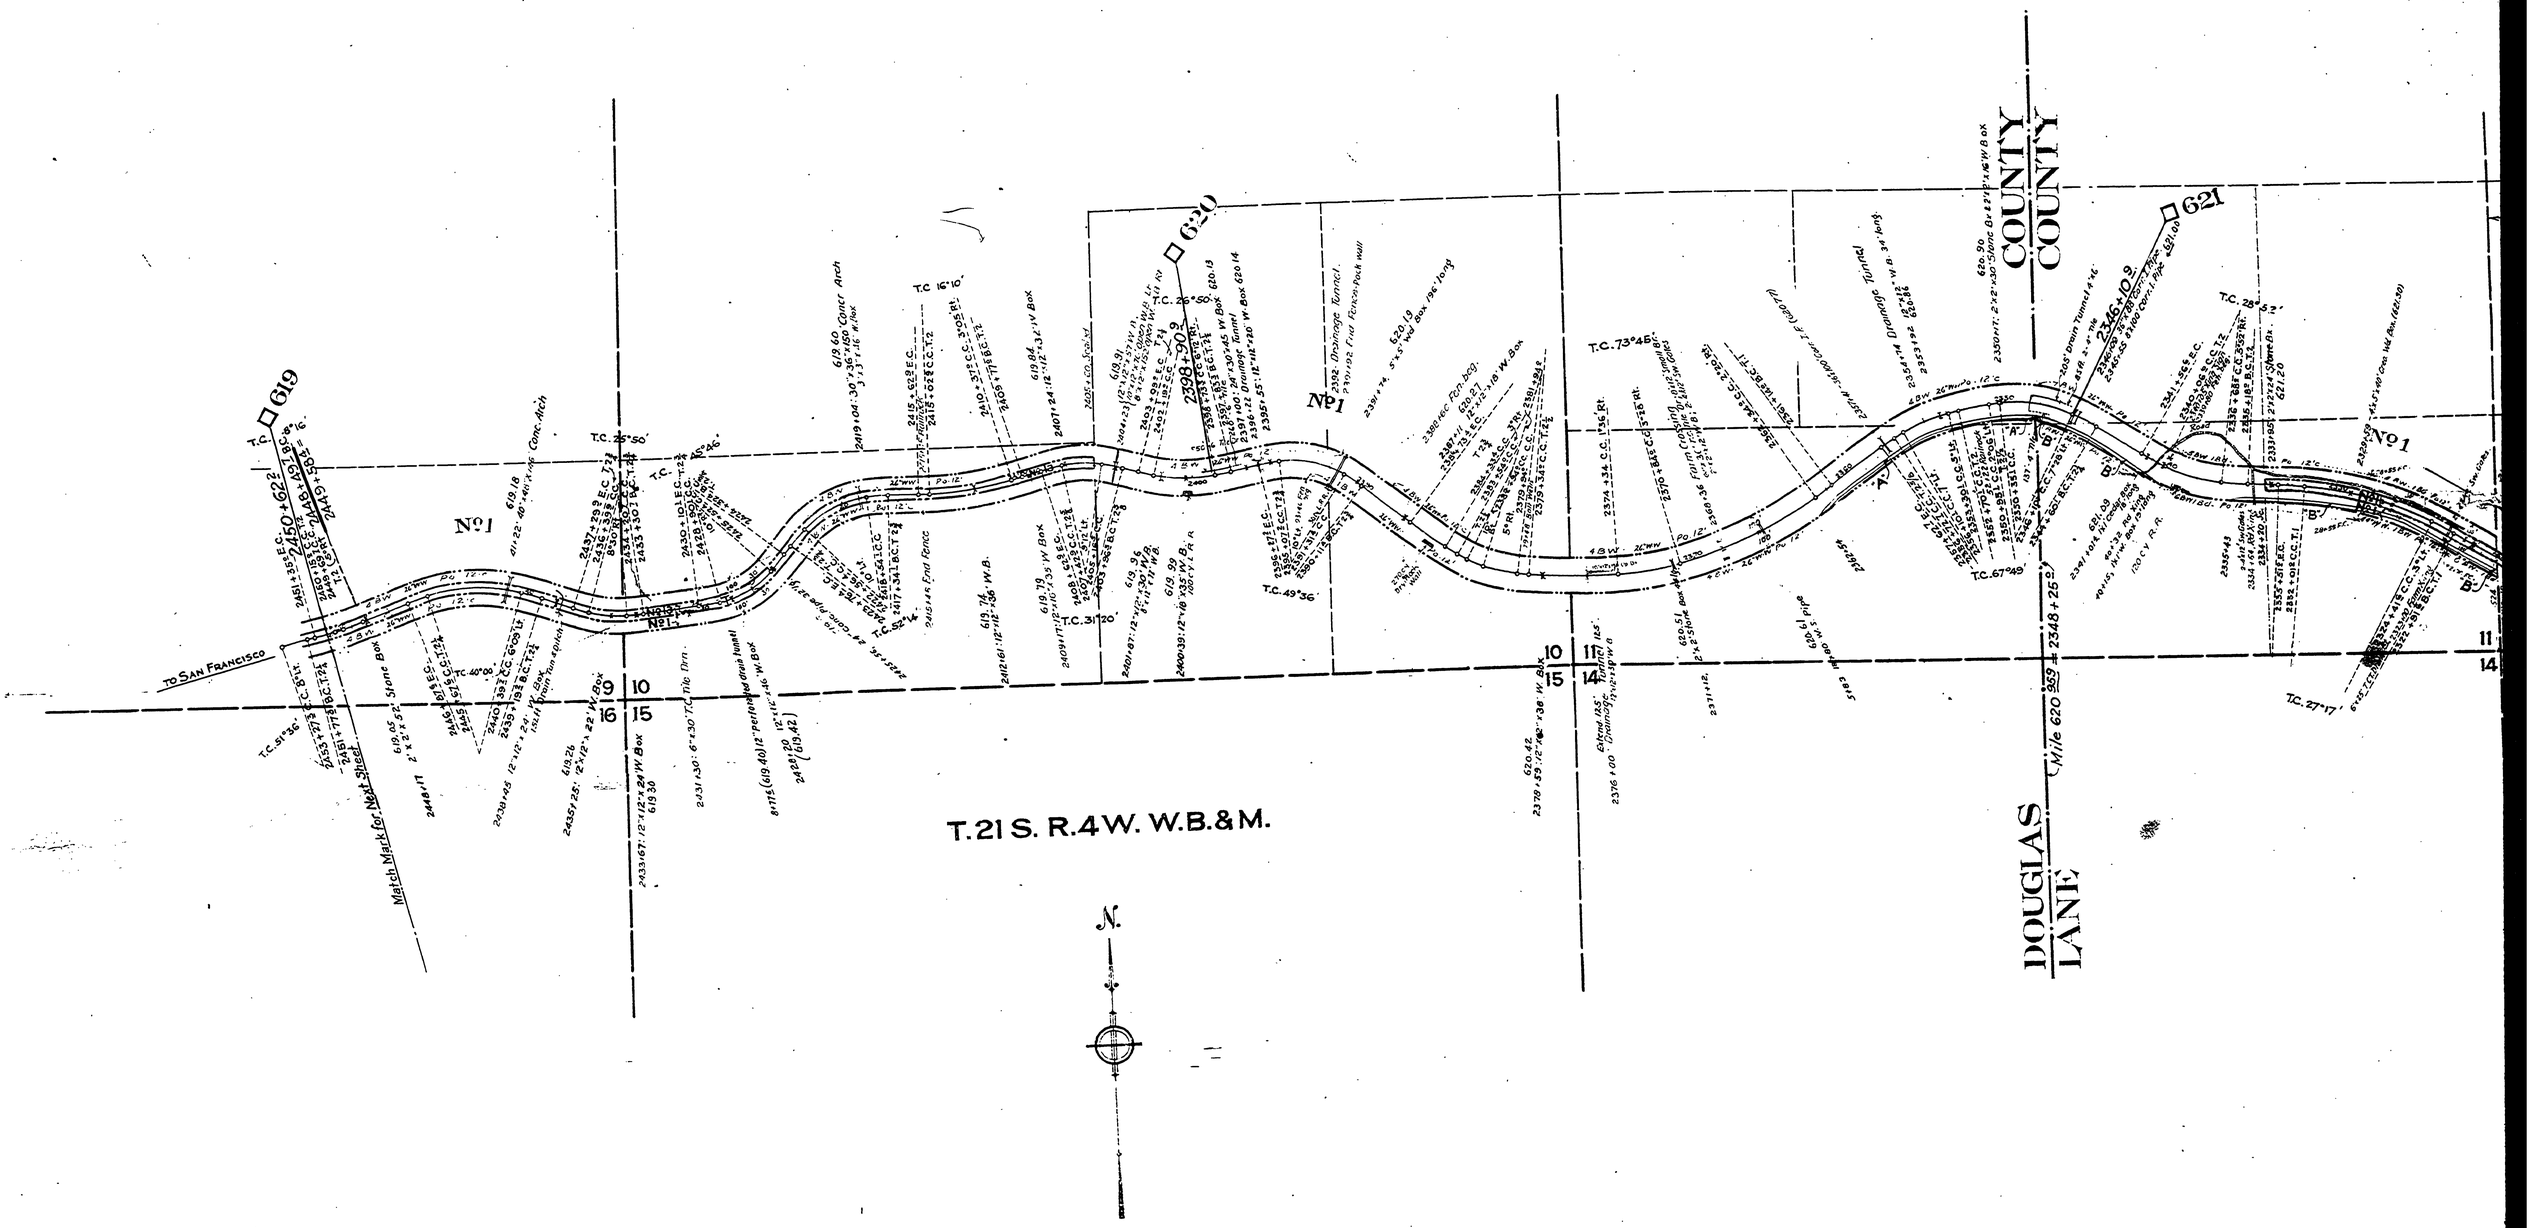
COUNTY
COUNTY
DOUGLAS
LANE
T.21 S. R.4 W. W.B.&M.
N.
TO SAN FRANCISCO
Match Mark for Next Sheet
619
620
621
2398+90
2346+10
2348+25
Drainage Tunnel
Concr. Arch
Stone Box
Drain Tunnel
Concr. Pipe
Concr. Culvert
Fence
Wire Fence
Post Fence
Rock Wall
Concrete Pipe
Wood Box
