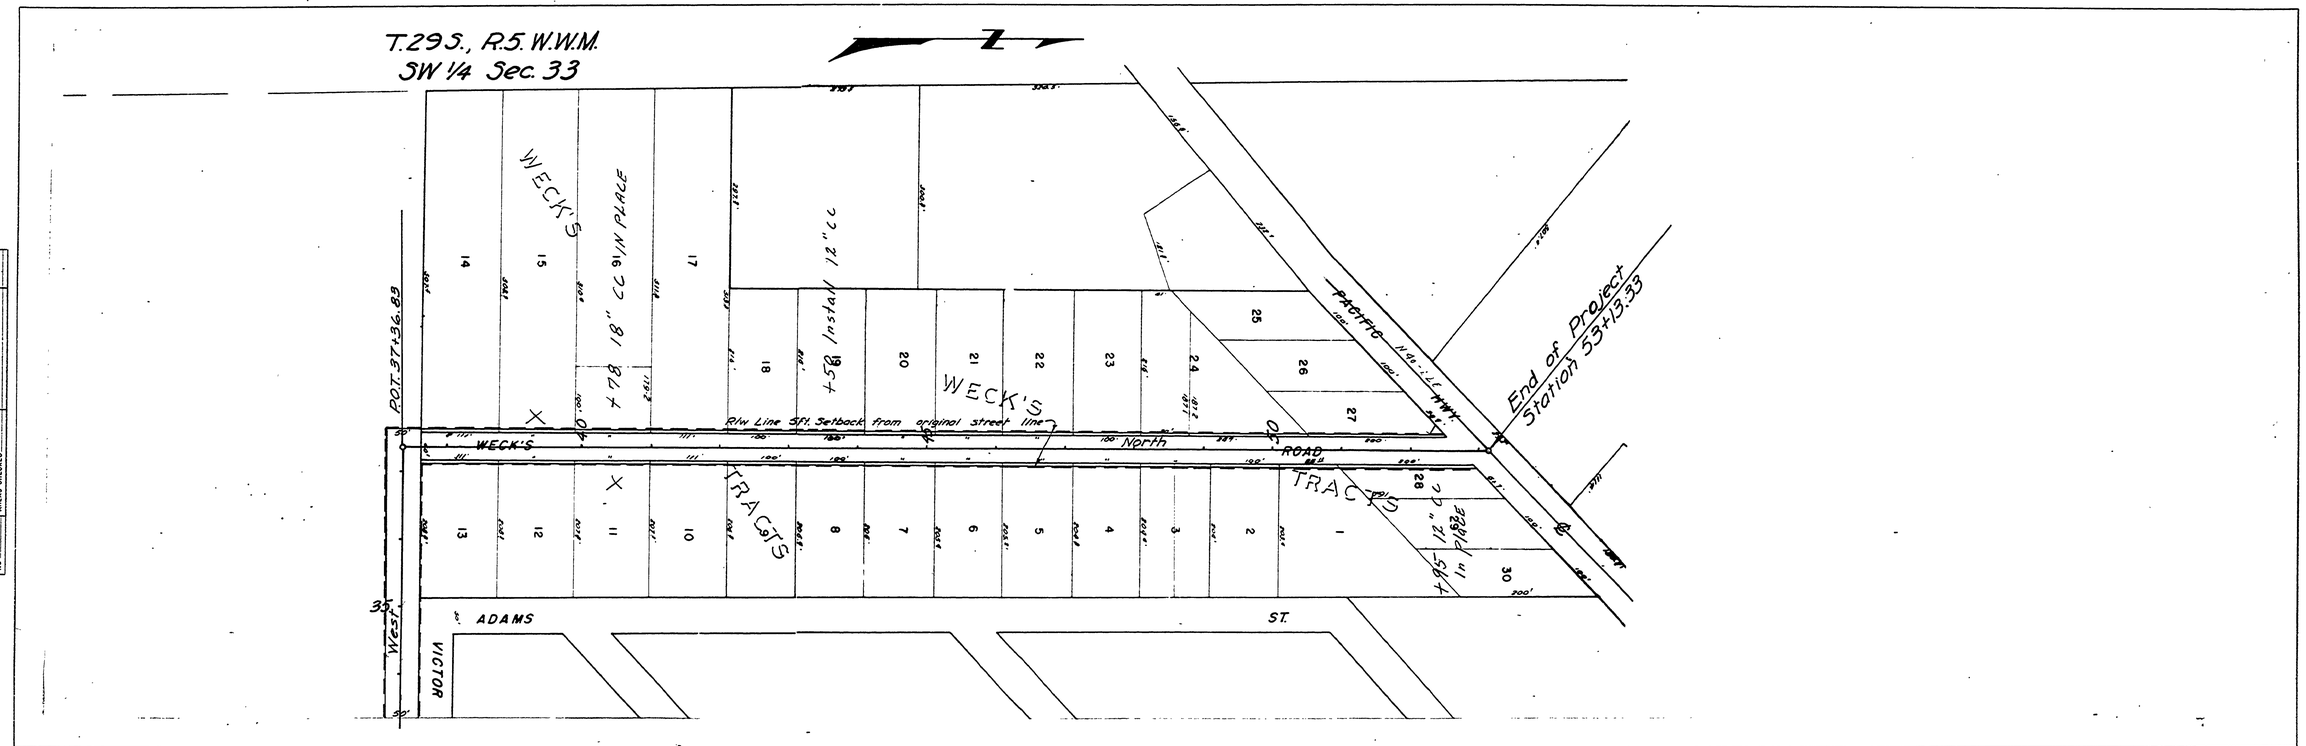

Note: Limits of adopted road shown thus - - - - -

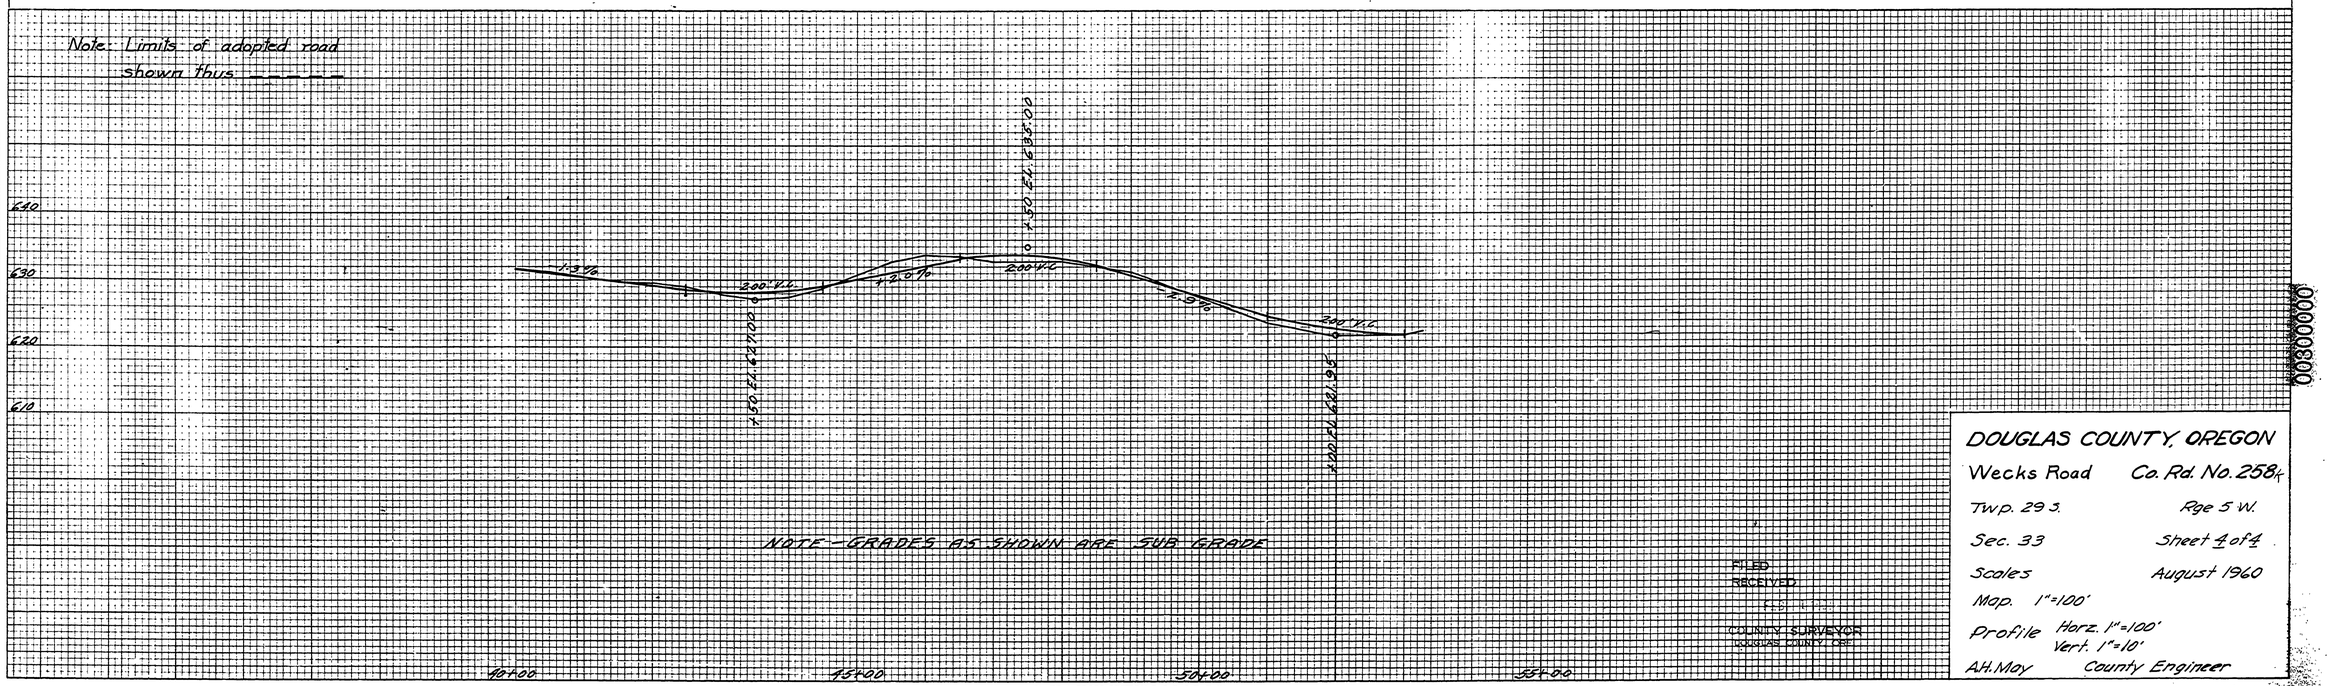

NOTE - GRADES AS SHOWN ARE SUB GRADE

FILED
RECEIVED
COUNTY SURVEYOR
DOUGLAS COUNTY, ORE.

DOUGLAS COUNTY, OREGON

Wecks Road — Co. Rd. No. 258K

Twp. 29 S. — Rge 5 W.

Sec. 33 — Sheet 4 of 4

Scales — August 1960

Map. 1"=100'

Profile Horz. 1"=100'
Vert. 1"=10'

A.H. May — County Engineer

PLATE 4 CROSS SECTION B. P. R. & R. E. STANDARD
EUGENE DIETZGEN CO., CHICAGO · NEW YORK

M.P. 0.30 - 0.00

Co. Rd. #258K — Aug. 1960 — Sht 4 of 4

FINAL SURVEY		BY	DATE
NOTE BOOK	SURVEYED		
	PLOTTED		
	TEMPLATE		
	AREAS		
NO.	AREAS CHECKED		

ORIGINAL SURVEY		BY	DATE
NOTE BOOK	SURVEYED		
	PLOTTED		
	TEMPLATE		
	AREAS		
NO.	AREAS CHECKED		