BW 5-50

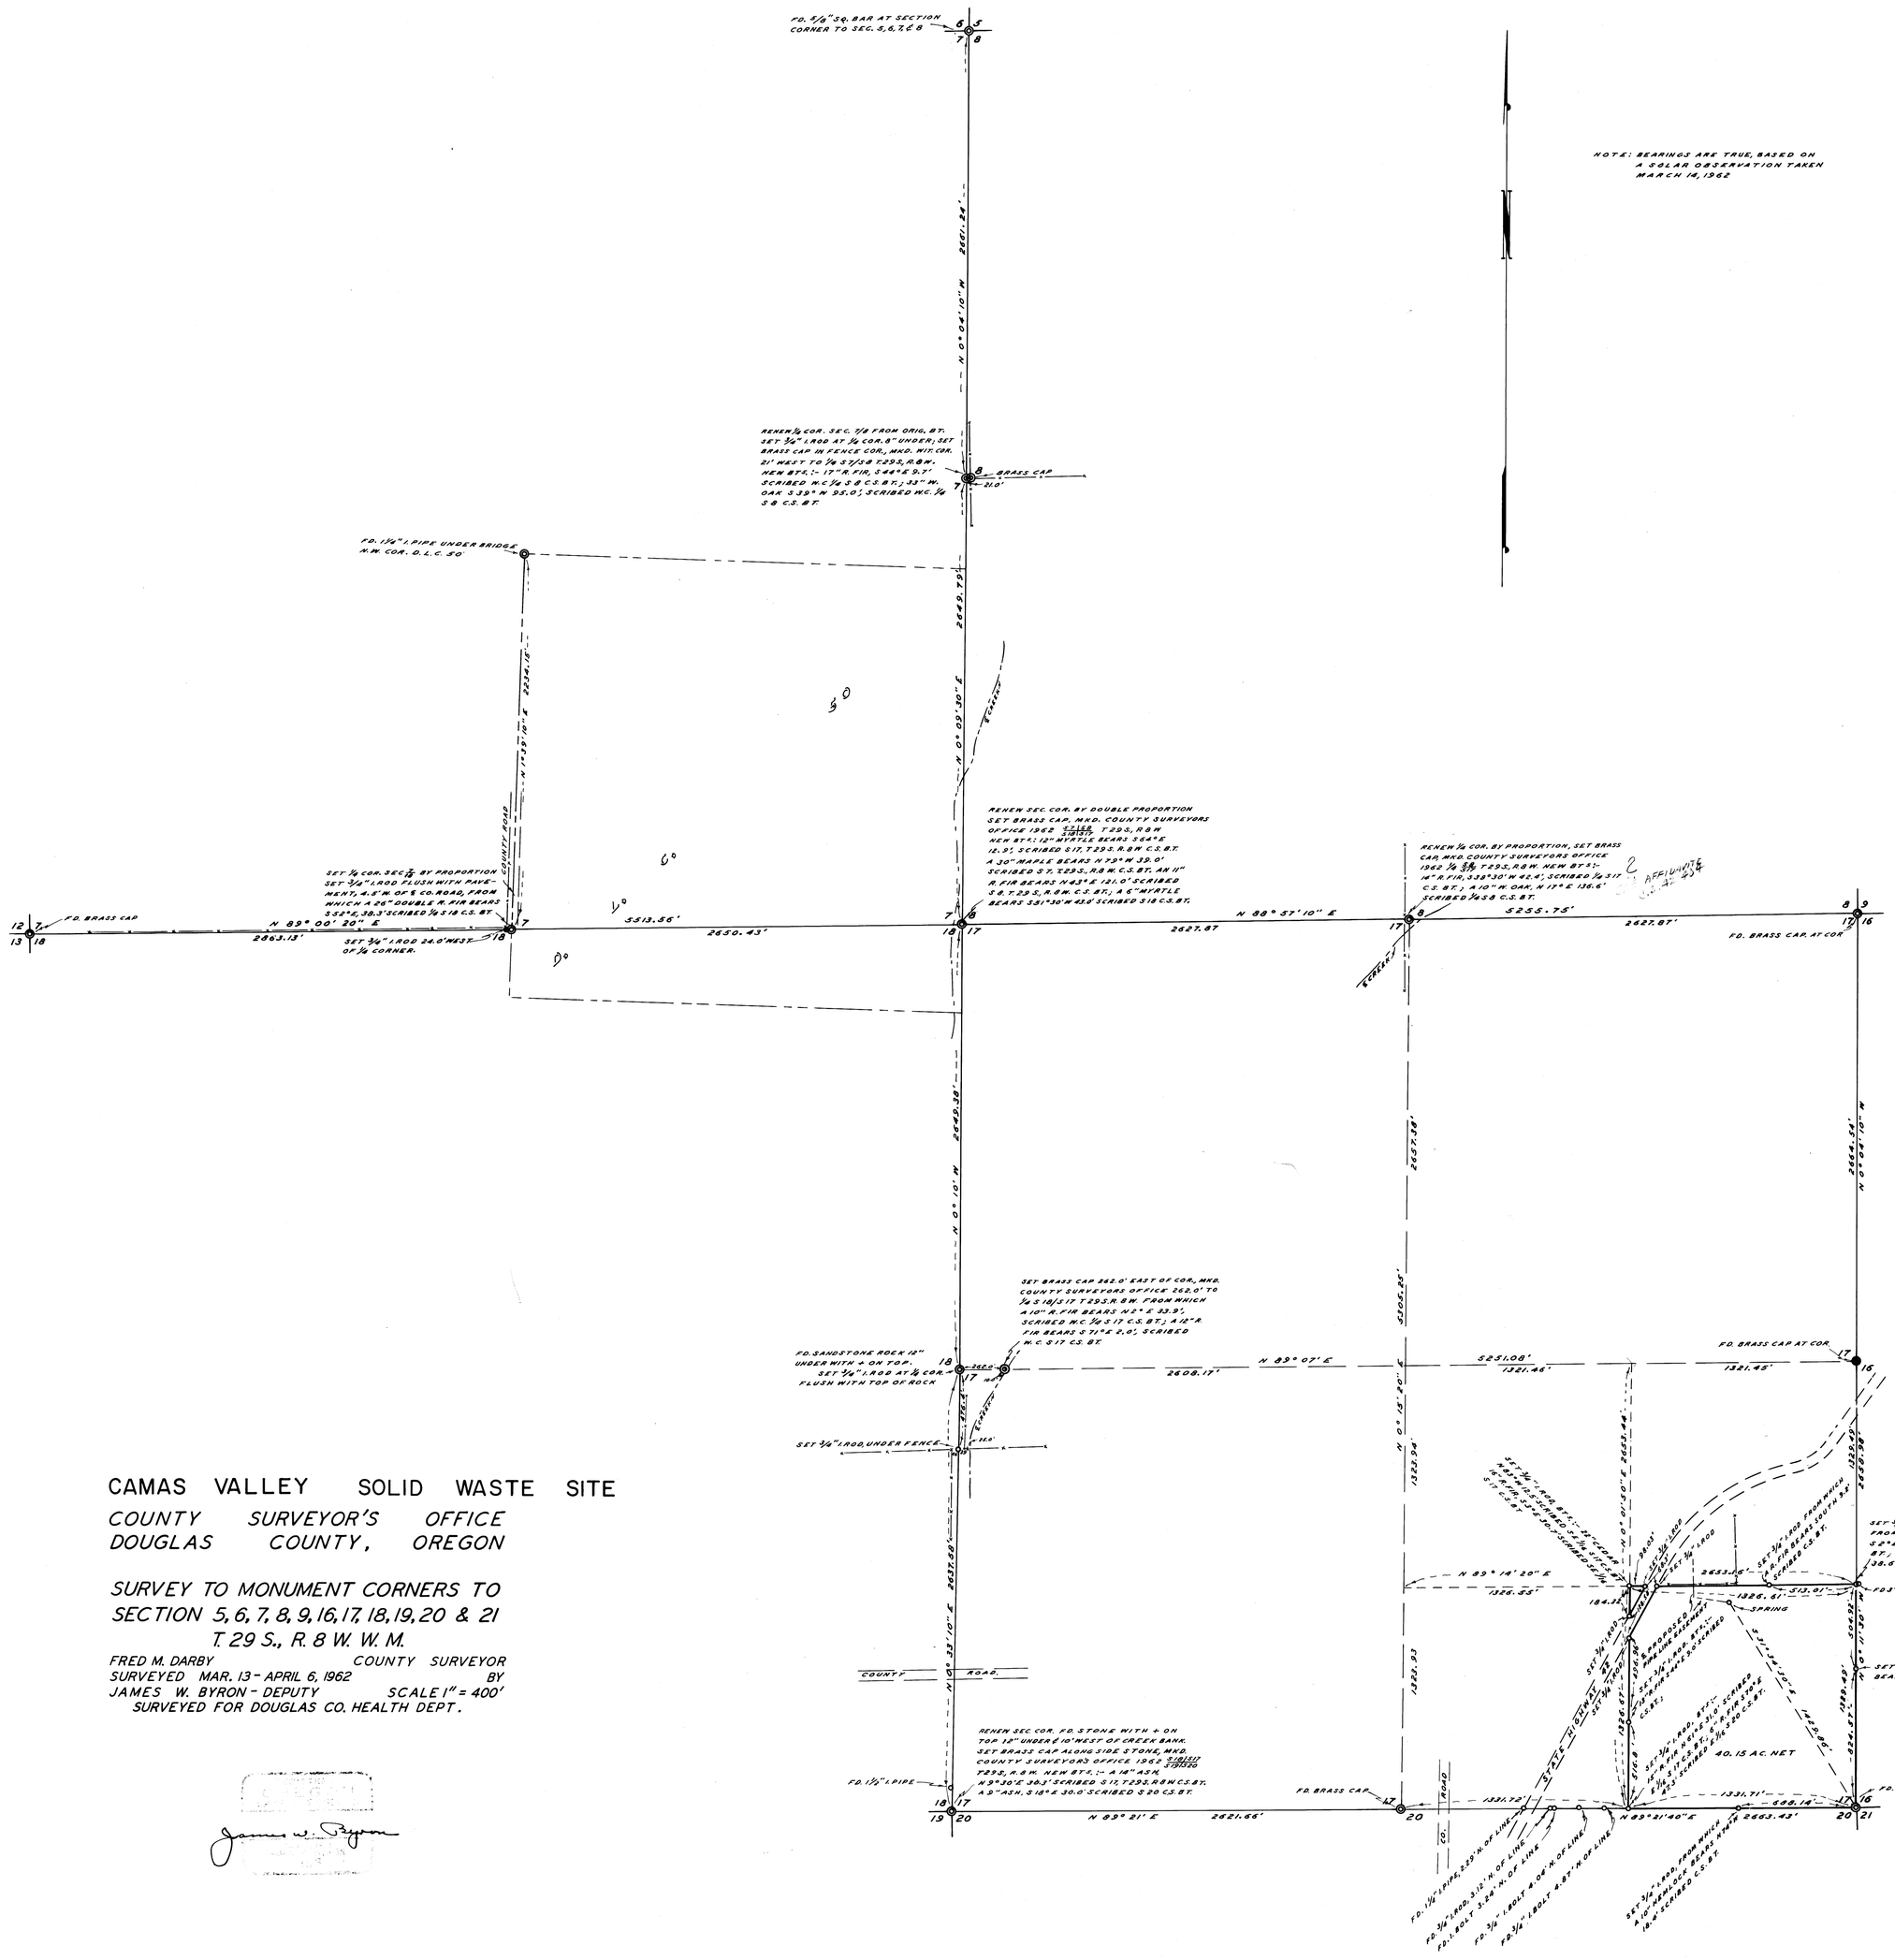

CAMAS VALLEY SOLID WASTE SITE

COUNTY SURVEYOR'S OFFICE
DOUGLAS COUNTY, OREGON

SURVEY TO MONUMENT CORNERS TO
SECTION 5, 6, 7, 8, 9, 16, 17, 18, 19, 20 & 21
T. 29 S., R. 8 W. W. M.

FRED M. DARBY — COUNTY SURVEYOR
SURVEYED MAR. 13 - APRIL 6, 1962 — BY
JAMES W. BYRON - DEPUTY — SCALE 1" = 400'
SURVEYED FOR DOUGLAS CO. HEALTH DEPT.

James W. Byron