U. S. DEPARTMENT OF AGRICULTURE
BUREAU OF PUBLIC ROADS-DIST. NO. 1
Diamond Lake Hwy.
NATIONAL FOREST ROAD
Grading
Oregon WIDTH 22'

PROJECT No. 43-C1
SHEET No.
Total Sheets

1932 Std.

UMPQUA NATIONAL FOREST

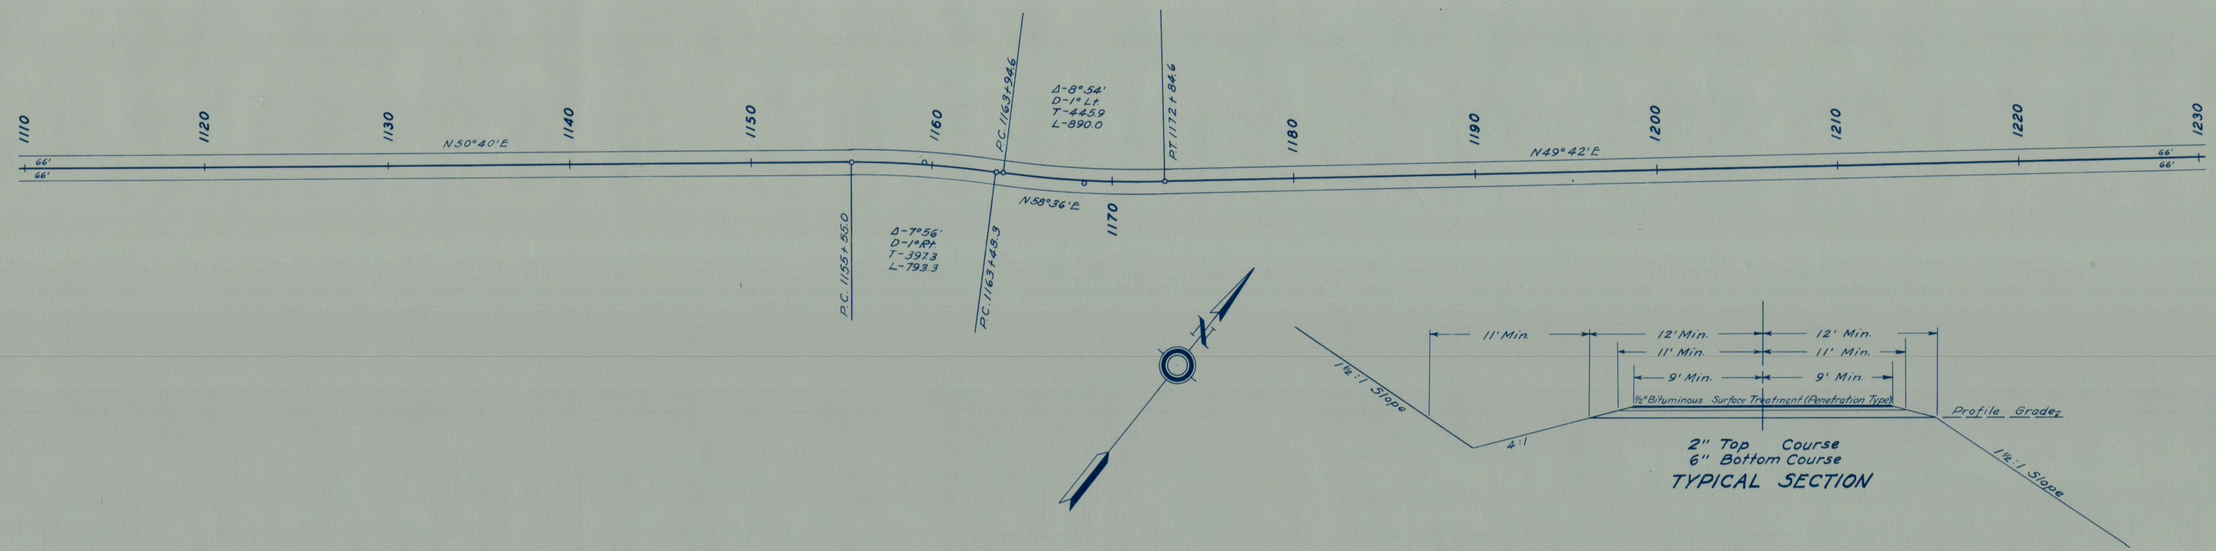

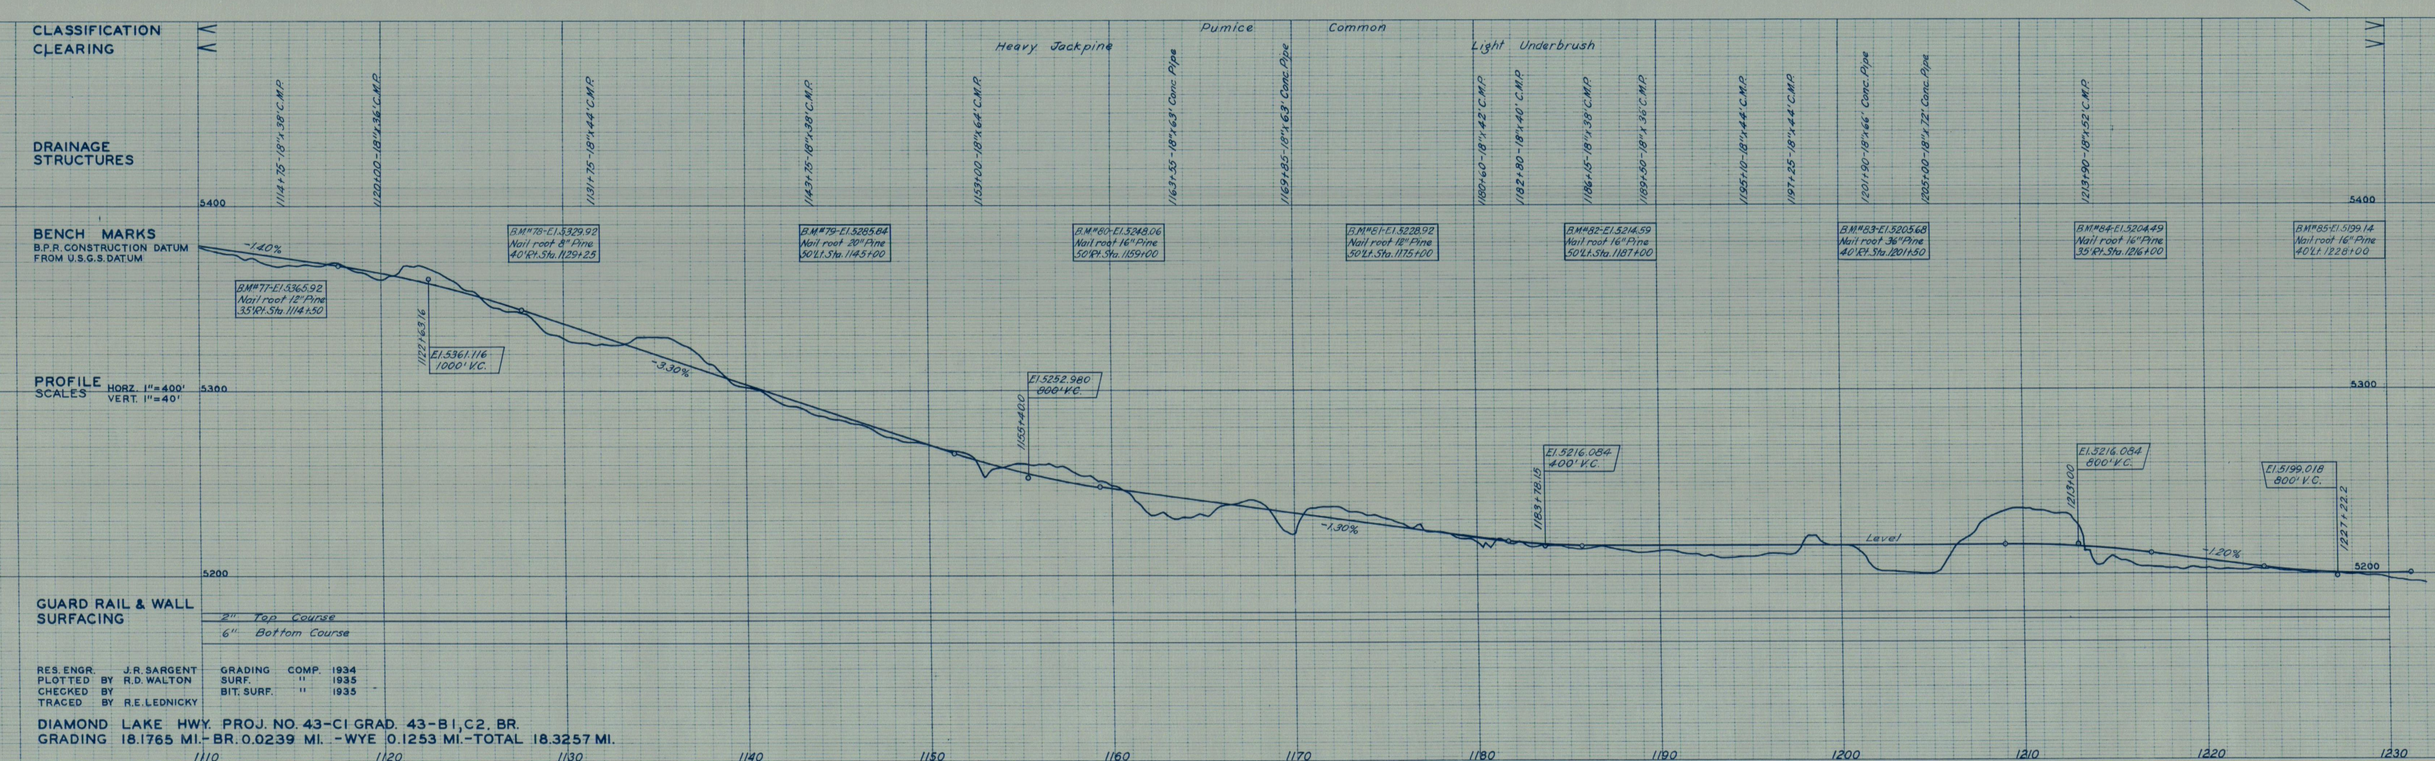

RES. ENGR. J.R. SARGENT
PLOTTED BY R.D. WALTON
CHECKED BY
TRACED BY R.E. LEDNICKY

GRADING COMP. 1934
SURF. " 1935
BIT. SURF. " 1935

DIAMOND LAKE HWY. PROJ. NO. 43-C1 GRAD. 43-B1, C2. BR.
GRADING 18.1765 MI.-BR. 0.0239 MI. -WYE 0.1253 MI.-TOTAL 18.3257 MI.