Diamond Lake Hwy. Grading Oregon	Project No. 43-C1 Sheet No.

1932 Std.

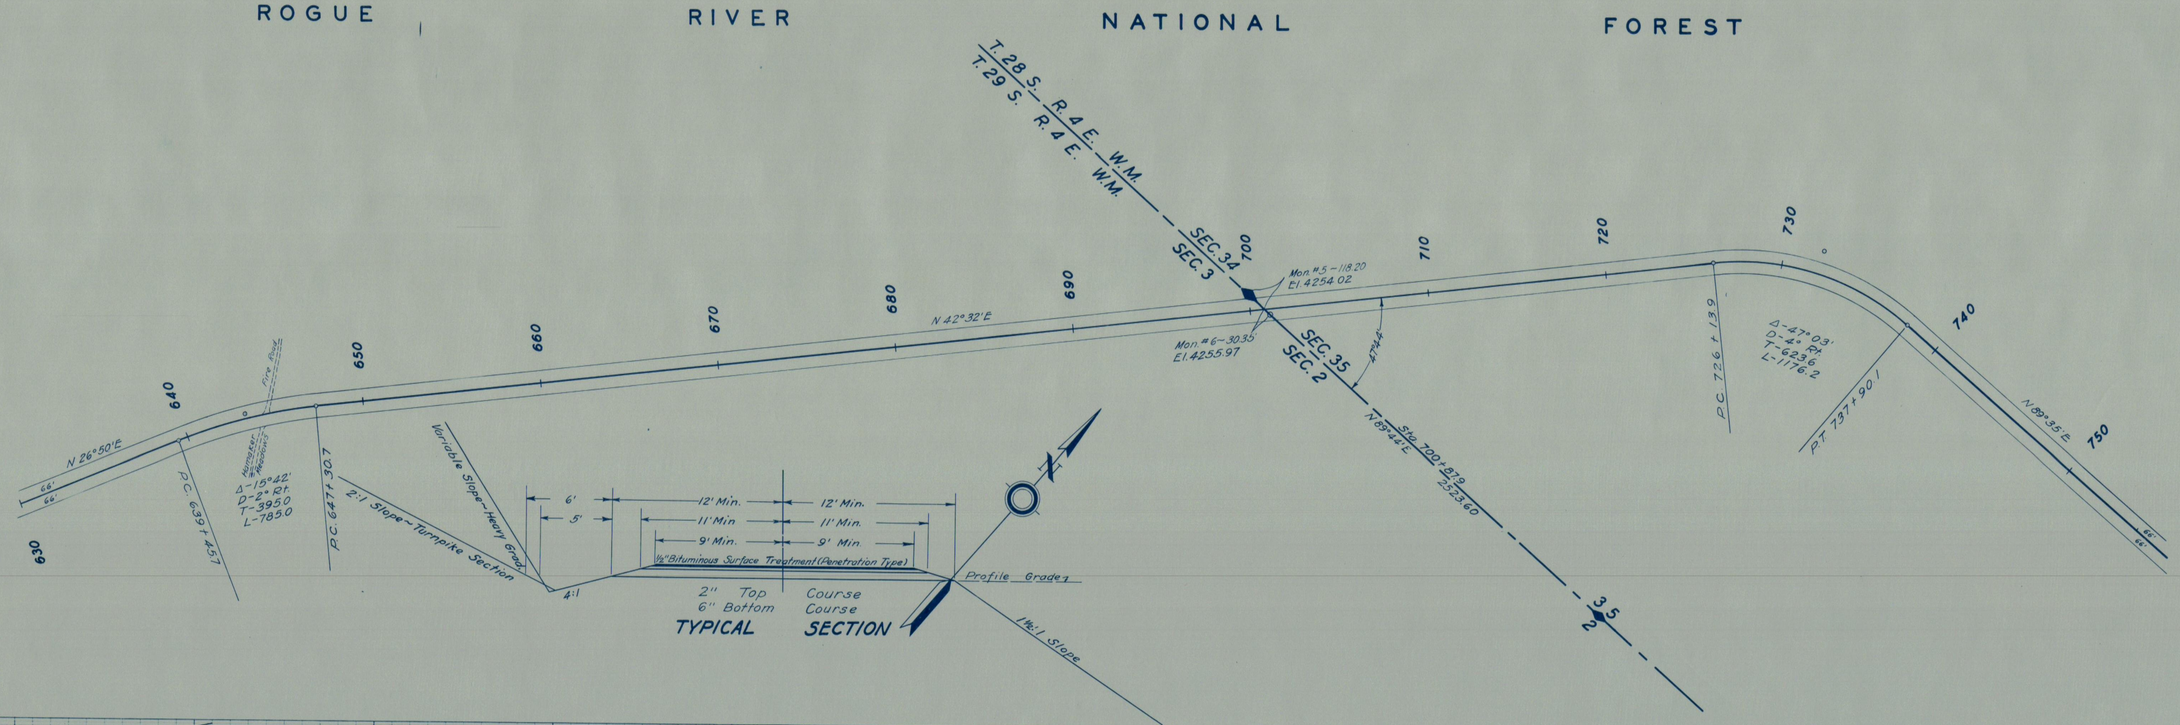

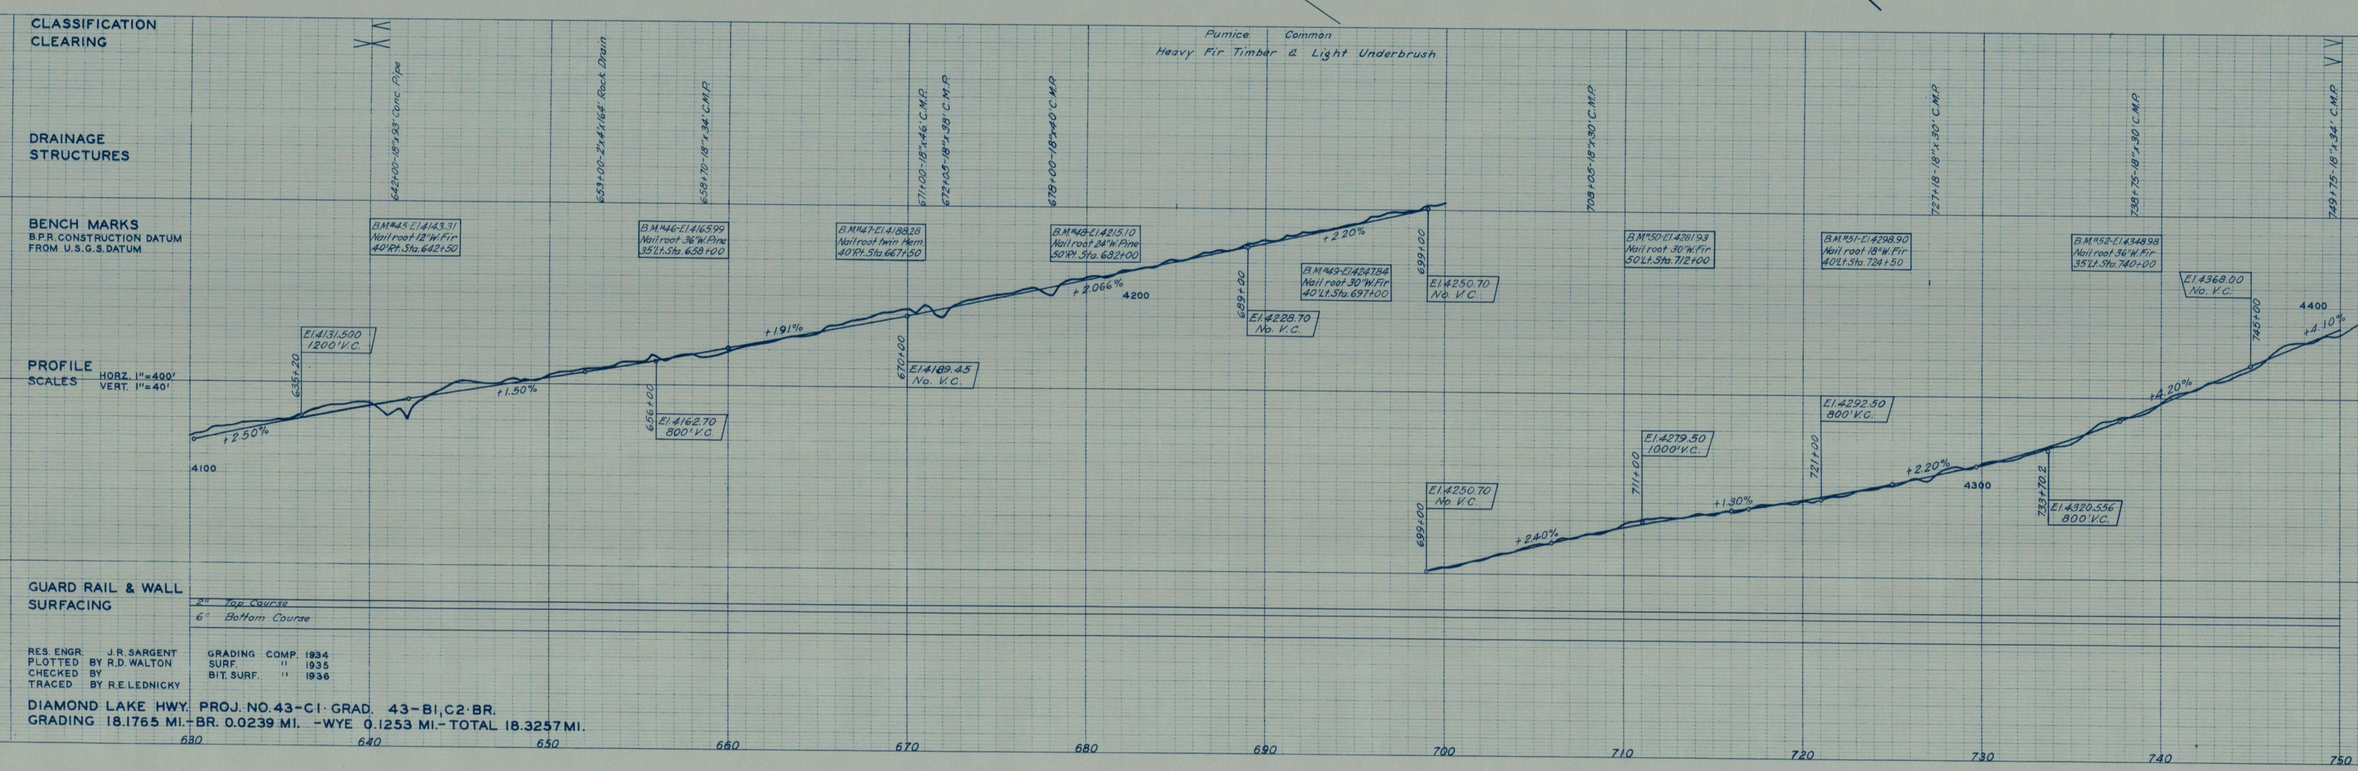

RES. ENGR. J. R. SARGENT
PLOTTED BY R.D. WALTON
CHECKED BY
TRACED BY R.E. LEDNICKY

GRADING COMP. 1934
SURF. " 1935
BIT. SURF. " 1936

DIAMOND LAKE HWY. PROJ. NO. 43-C1 GRAD. 43-B1, C2 BR.
GRADING 18.1765 MI.-BR. 0.0239 MI. -WYE 0.1253 MI.- TOTAL 18.3257 MI.