STATE HIGHWAY DEPARTMENT OF OREGON — BUREAU OF PUBLIC ROADS — FOR USE ON FEDERAL AID PROJECTS ONLY	PROJECT No. 43-C1
Diamond Lake Hwy.	SHEET No.
Grading	Total Sheets
K. Oregon — Width 22'	

1932 Std.

ROGUE RIVER NATIONAL FOREST

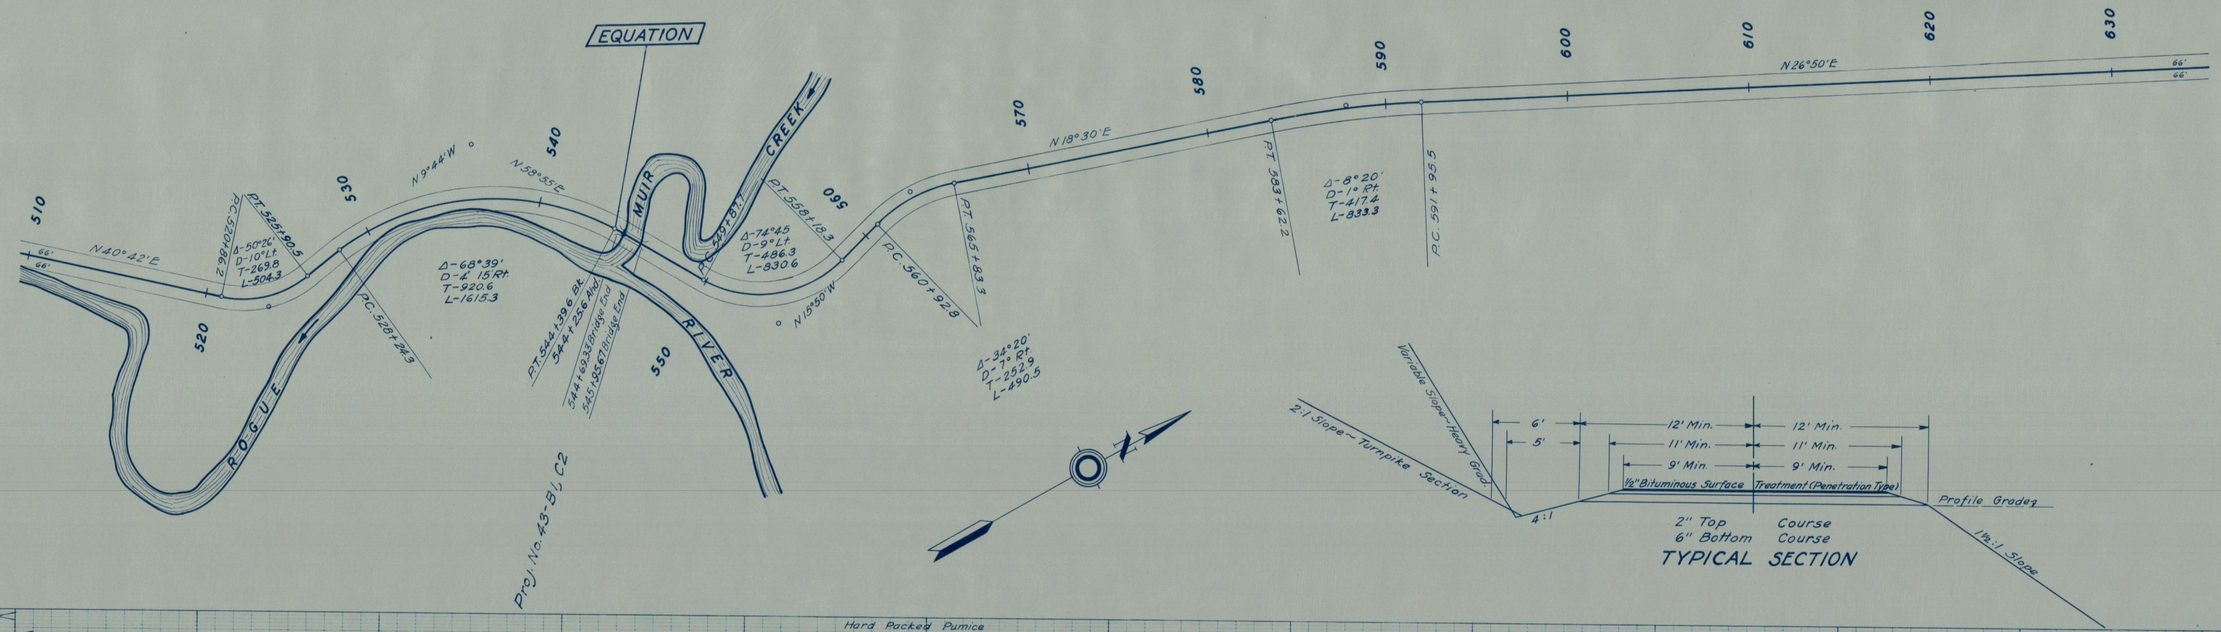

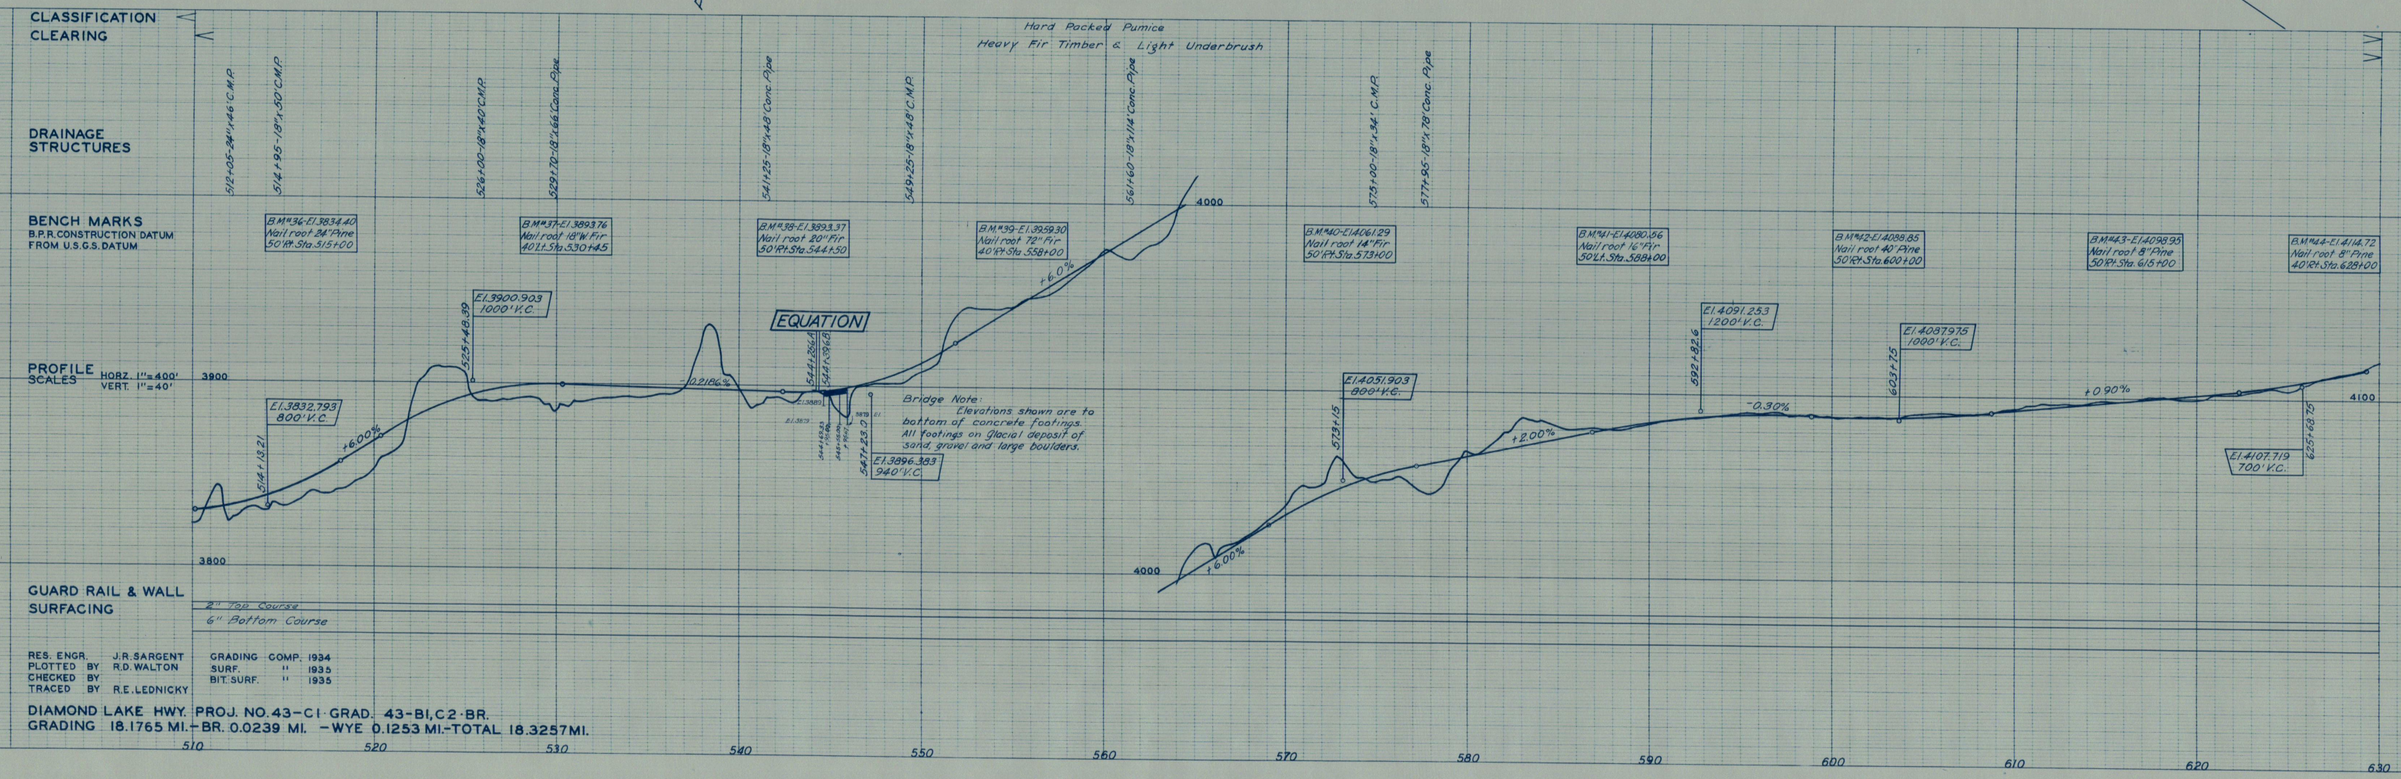

RES. ENGR.	J.R. SARGENT	GRADING COMP.	1934
PLOTTED BY	R.D. WALTON	SURF. "	1935
CHECKED BY		BIT. SURF. "	1935
TRACED BY	R.E. LEDNICKY		

DIAMOND LAKE HWY. PROJ. NO. 43-C1 GRAD. 43-B1, C2-BR.
GRADING 18.1765 MI.-BR. 0.0239 MI. -WYE 0.1253 MI.-TOTAL 18.3257 MI.