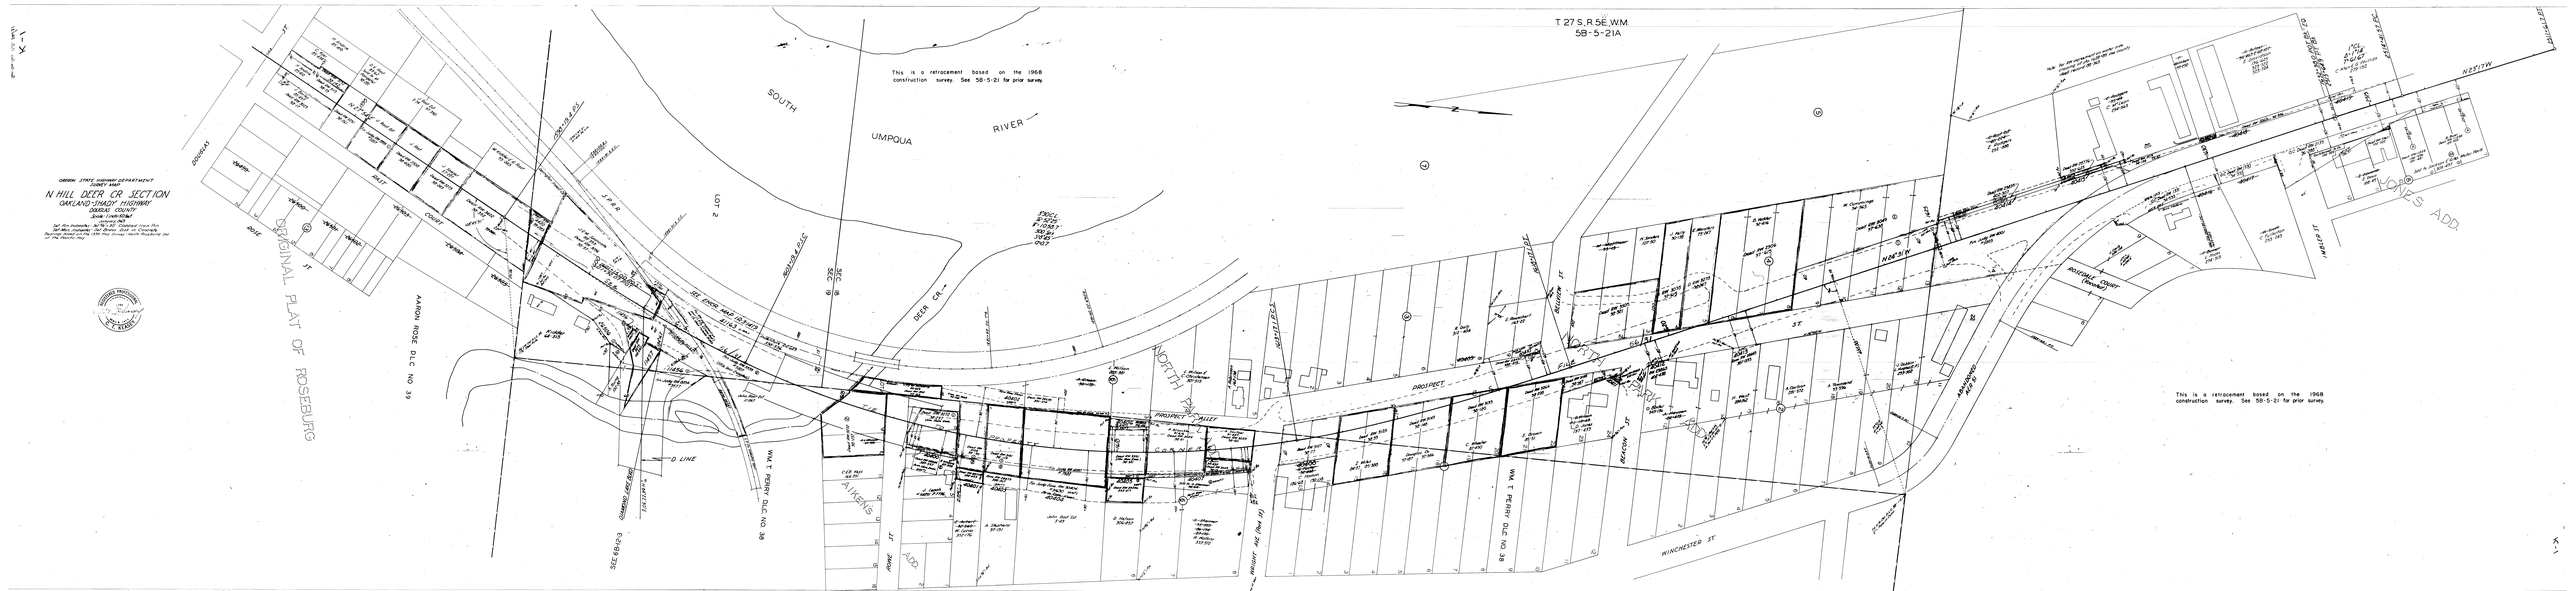
T 27 S, R 5E, W.M.
5B-5-21A
OREGON STATE HIGHWAY DEPARTMENT
N HILL DEER CR SECTION
OAKLAND-SHADY HIGHWAY
DOUGLAS COUNTY
This is a retracement based on the 1968 construction survey. See 5B-5-21 for prior survey.
SOUTH UMPQUA RIVER
DEER CR.
ORIGINAL PLAT OF ROSEBURG
AARON ROSE D.L.C. NO. 39
WM. T. PERRY D.L.C. NO. 38
LOT 2
SEC 8
SEC 9
SEC 16
SEC 17
T 28 S
T 27 S
PROSPECT
NORTH PROSPECT
PROSPECT VALLEY
BALDWIN ST
WINCHESTER ST
ROSEBURG ADD.
N 23°21'W
N 64°31'W
N 23°21'W
This is a retracement based on the 1968 construction survey. See 5B-5-21 for prior survey.