DOUGLAS COUNTY
T. 26 S., R. 2 W., W.M.

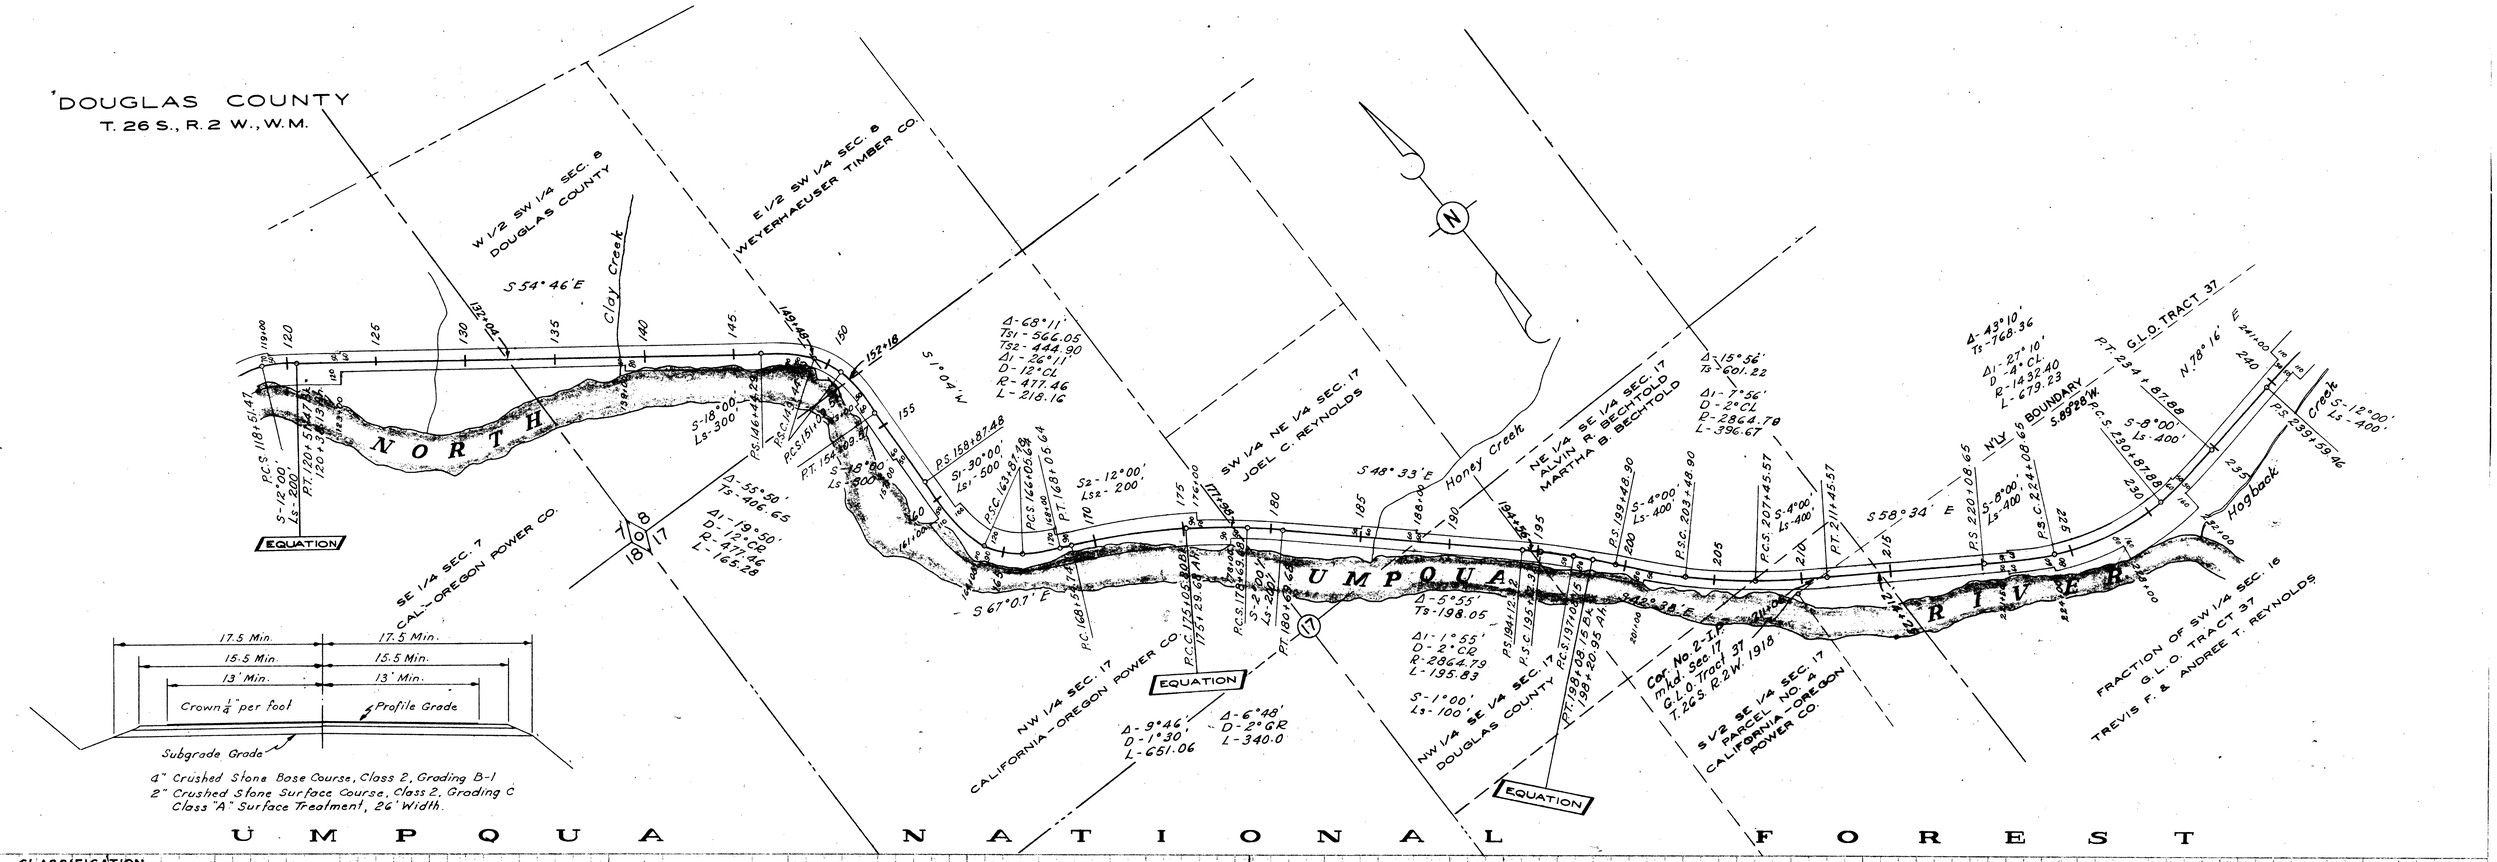

U M P Q U A N A T I O N A L F O R E S T

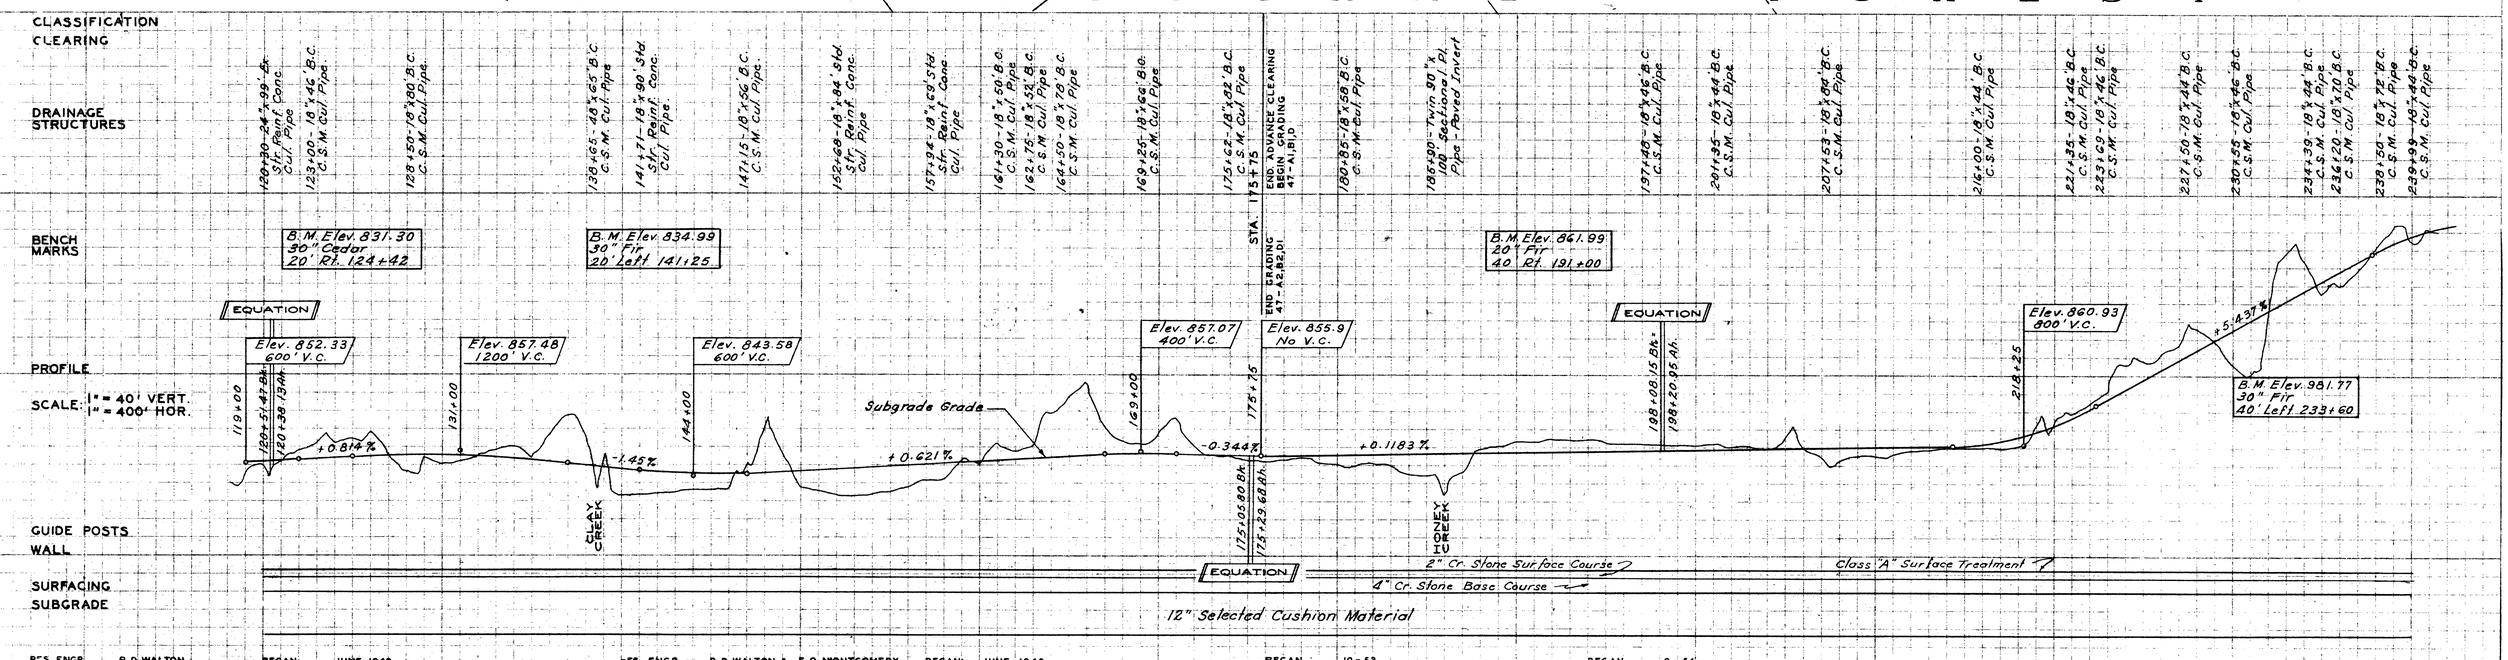

RES. ENGR. R.D. WALTON PLOTTED BY: E.L. WHITE CHECKED BY: R.R. LANGNESE TRACED BY: E.L. WHITE	BEGAN: JUNE 1948 COMPLETED: SEPT. 1949	RES. ENGR. R.D. WALTON & F.O. MONTGOMERY PLOTTED BY: E.L. WHITE CHECKED BY: R.R. LANGNESE TRACED BY: E.L. WHITE	BEGAN: JUNE 1949 COMPLETED: JULY 1950	BEGAN 10-53 COMPLETED 3-55	BEGAN 9-54 COMPLETED 7-55
NORTH UMPQUA HIGHWAY — PROJECT NO. 47-A1,B1,D GRADING — 2.207 MILES	ADVANCE CLEARING — 3.580 MILES	NORTH UMPQUA HIGHWAY — PROJECT NO. 47-A2,B2,D1 GRADING — 3.274 MILES	SUBGRADE REINF. — 5.481 MILES	PROJ. NO. 47-A3,B6,C1,D2 SURFACING — 16.839 MILES	PROJ. NO. 47-A4,B7,C2,D4 BIT. SURFACE TREATMENT — 16.839 MILES