


DOUGLAS COUNTY

ALL SECTION 2
U.S. GOVERNMENT





ALL SECTION 31
U.S. GOVERNMENT

ALL SECTION 1
U.S. GOVERNMENT

ALL SECTION 6
U.S. GOVERNMENT

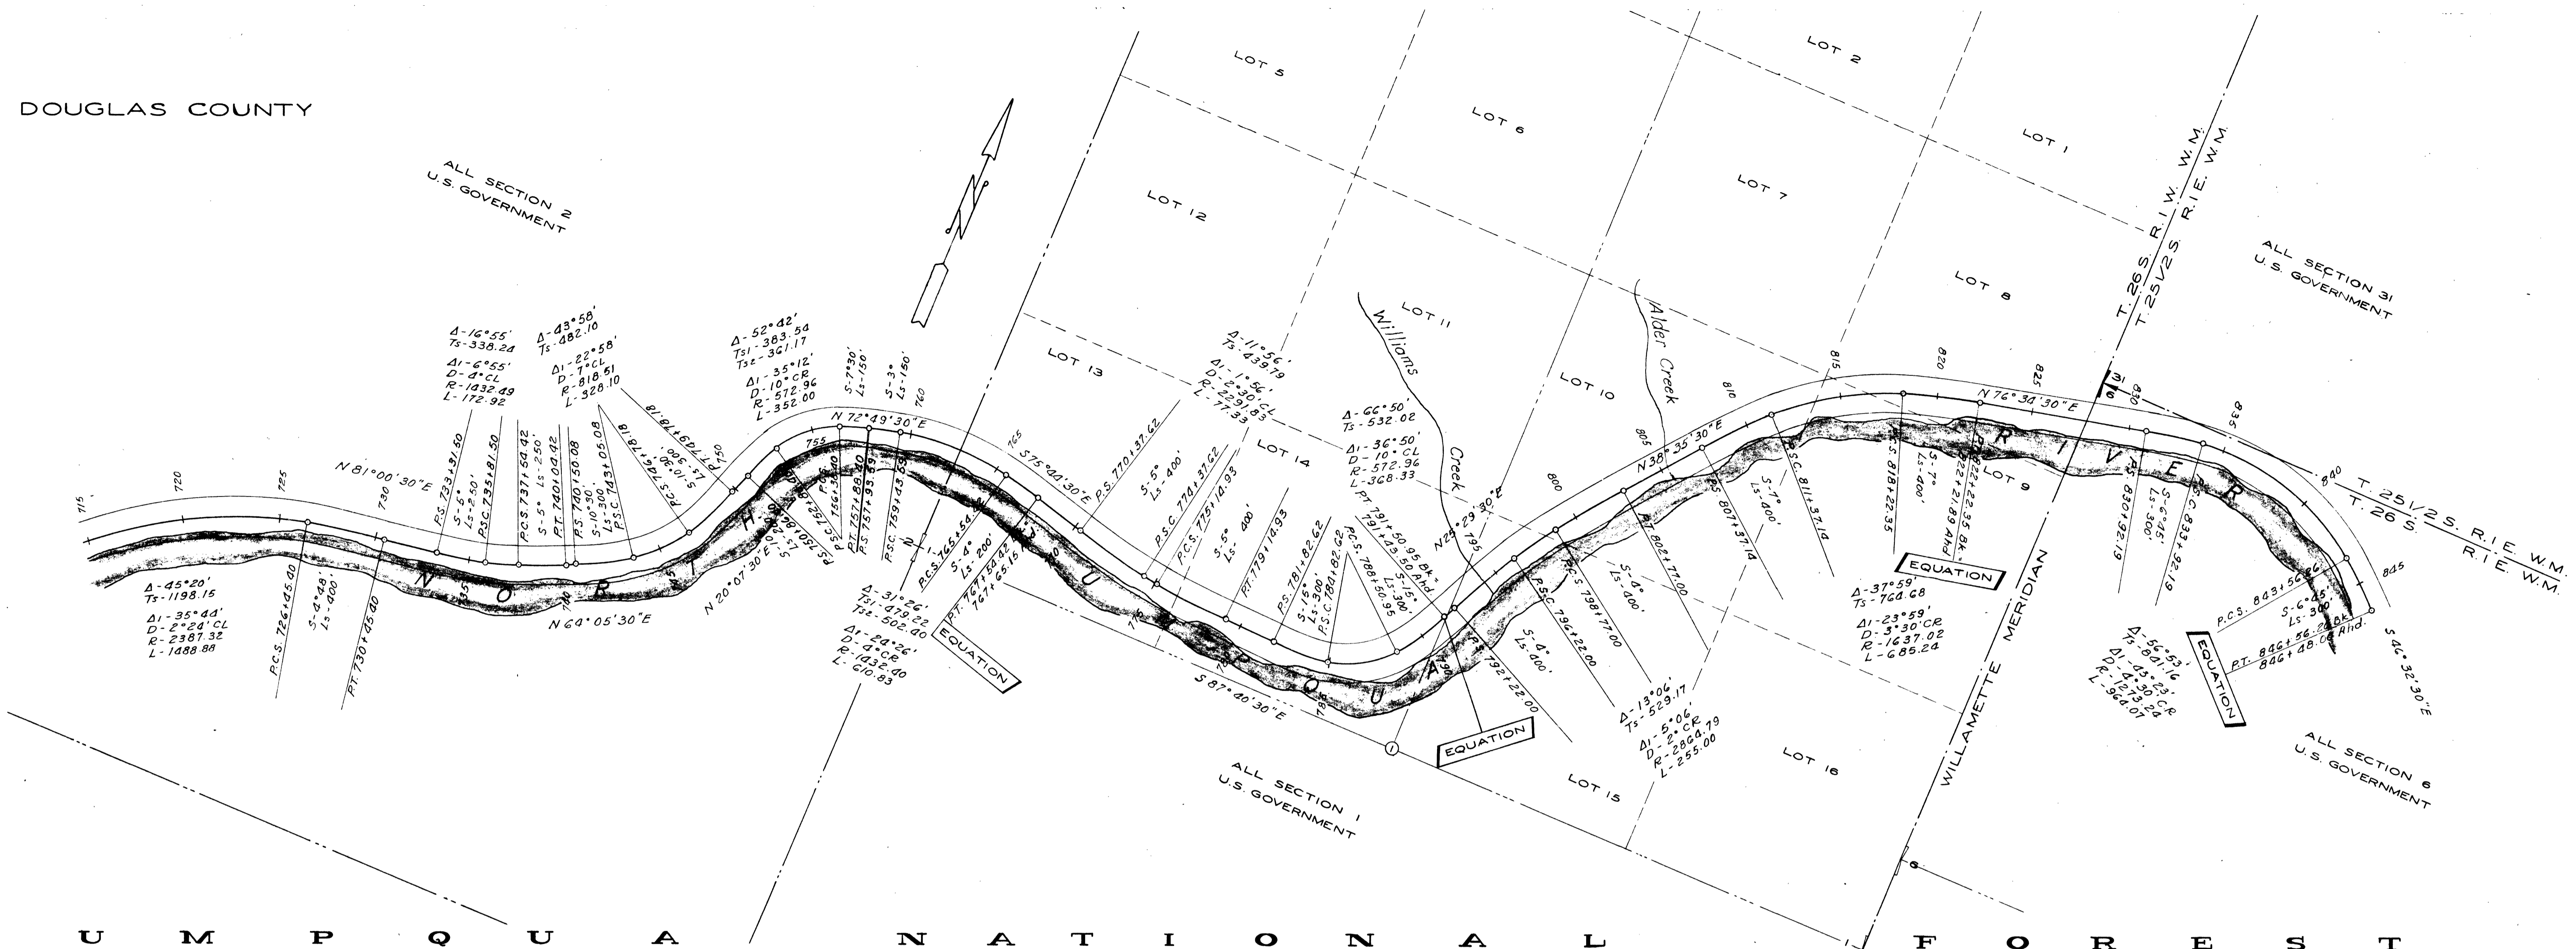

U M P Q U A N A T I O N A L F O R E S T

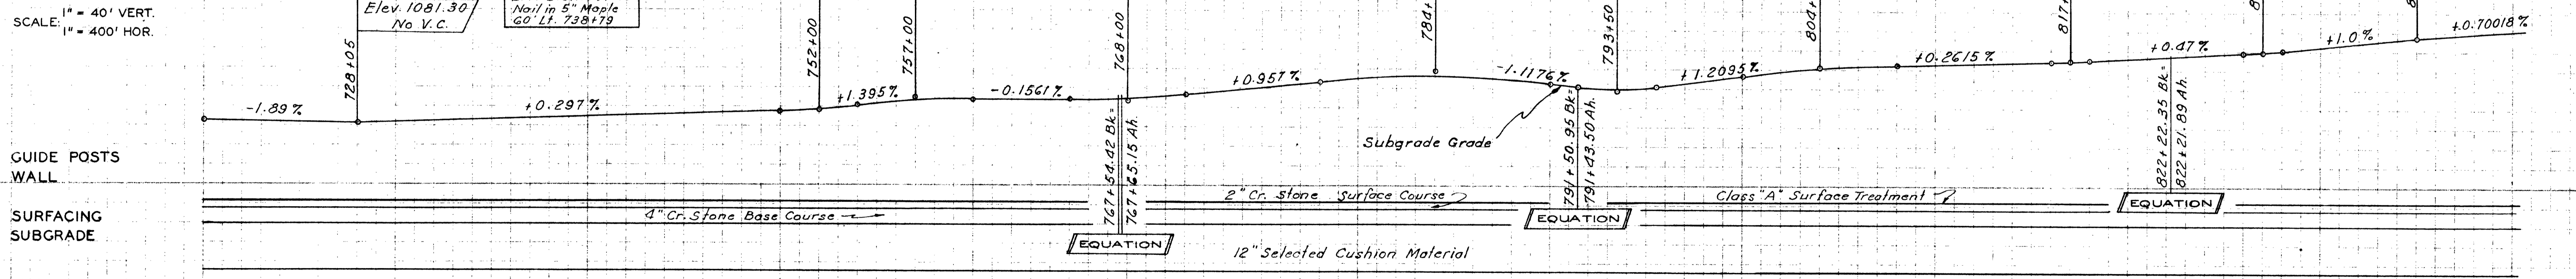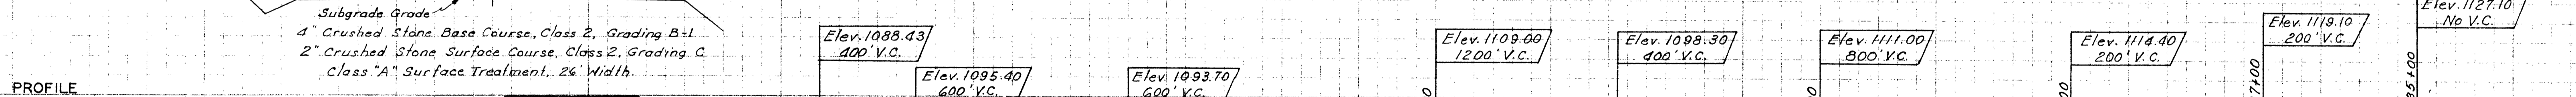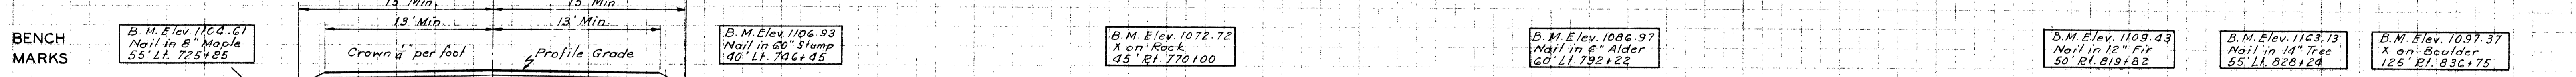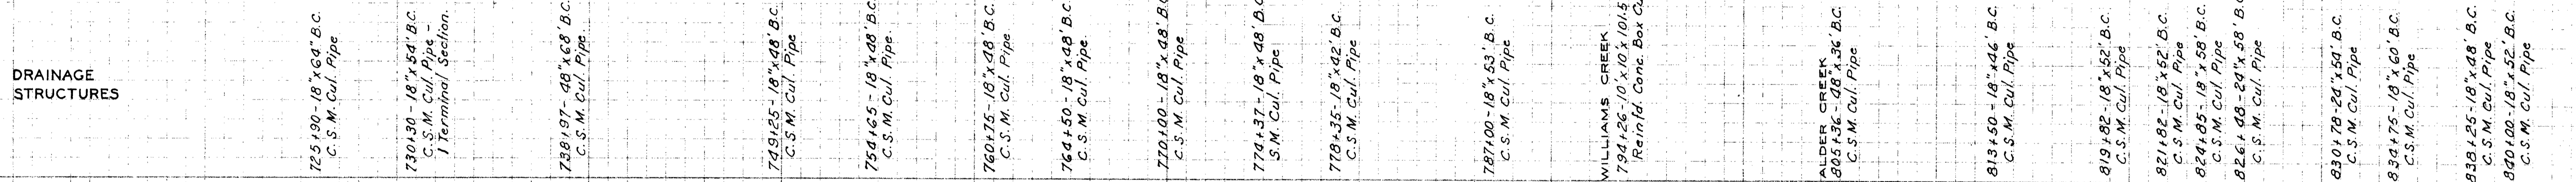

RES. ENGR. W. R. GRAFE PLOTTED BY: E. L. WHITE CHECKED BY: D. L. BLOOD TRACED BY: E. L. WHITE	BEGAN MAY 1952 COMPLETED DEC. 1953	BEGAN 10-53 COMPLETED 3-55	BEGAN 9-54 COMPLETED 7-55
--	---------------------------------------	-------------------------------	------------------------------

NORTH UMPQUA HIGHWAY - PROJ. NO. 47 - B5
GRADING - 4.304 MILES

PROJ. NO. 47 - A3, B6, C1, D2
SURFACING - 16.839 MILES

PROJ. NO. 47 - A4, B7, C2, D4
BIT. SURFACE TREATMENT - 16.839 MILES

