BOUNDARY SURVEY

IN THE SW 1/4 OF SEC. 9, T25S, R4W, W.M.

DOUGLAS COUNTY, OREGON

FOR GERARD R. AND MARY A. LAROSE

MARCH, 1994

FILED
Date: 4-13-94 By: JP
This survey consists of:
Map: M 118-56
Narrative: ____
Corner Rpt: ____
DOUGLAS COUNTY SURVEYOR

MAP FILE M 118-56

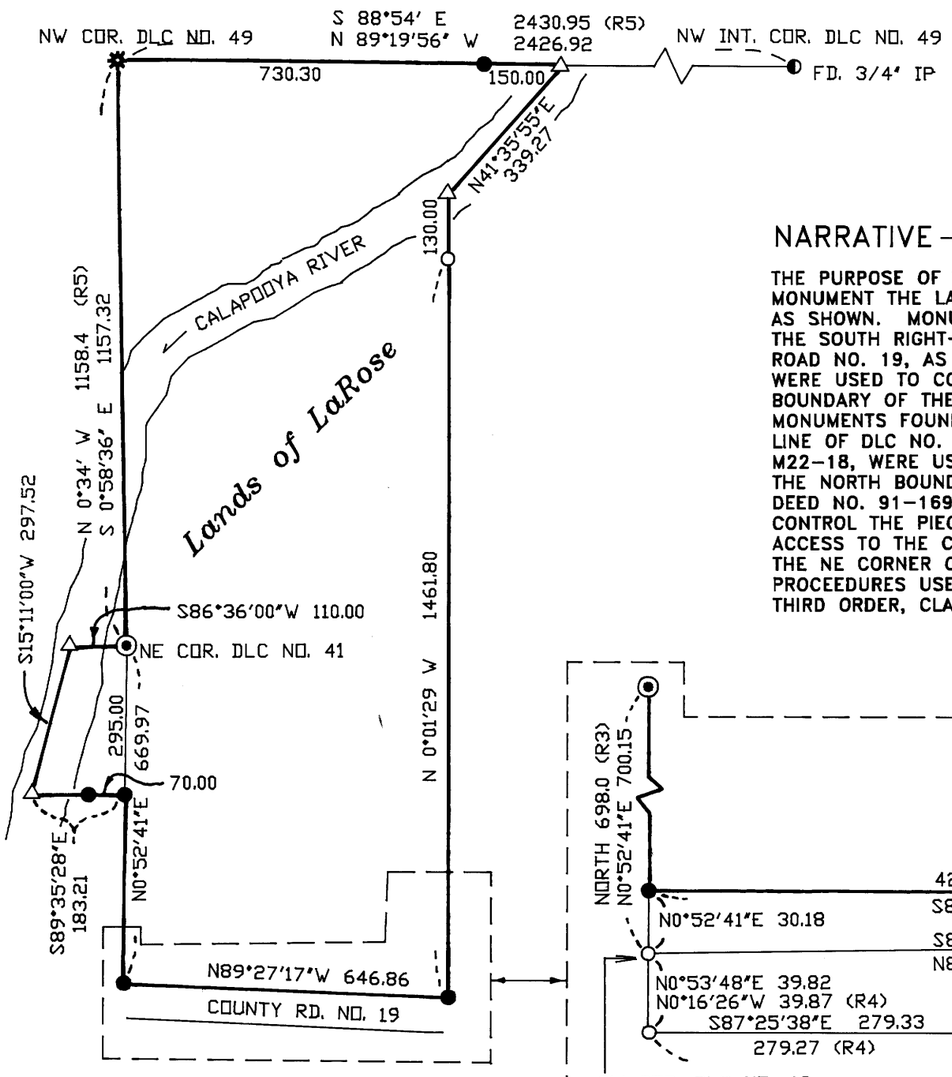

DETAIL NOT TO SCALE

NARRATIVE

THE PURPOSE OF THIS SURVEY WAS TO MONUMENT THE LANDS OF LAROSE AS SHOWN. MONUMENTS FOUND ALONG THE SOUTH RIGHT-OF-WAY OF COUNTY ROAD NO. 19, AS SHOWN IN M80-16, WERE USED TO CONTROL THE SOUTH BOUNDARY OF THE PROPERTY. THE MONUMENTS FOUND ON THE NORTHERLY LINE OF DLC NO. 49, AS SHOWN IN M22-18, WERE USED TO CONTROL THE NORTH BOUNDARY OF THE PROPERTY. DEED NO. 91-16950 WAS USED TO CONTROL THE PIECE OF PROPERTY GIVING ACCESS TO THE CALAPOOYA RIVER AT THE NE CORNER OF DLC NO. 41. THE PROCEEDURES USED FOR THE SURVEY MEET THIRD ORDER, CLASS II SPECIFICATIONS.

LEGEND

●	*SET 5/8" X 30" IRON ROD WITH PLASTIC CAP STAMPED "LS 2552".*
○	*FOUND 5/8" IRON ROD.*
◐	*FOUND 1" IRON PIPE (OR AS NOTED).*
◎	*FOUND 1-1/2" ALUMINUM CAP STAMPED "DOUGLAS CO. RIGHT OF WAY PC 375+28.28 35".*
⊙	*FOUND 2-1/2" BRASS CAP STAMPED "COUNTY SURVEYORS OFFICE, 1961. NE COR. DLC 41 T25S R4W".*
✱	*FOUND 1" IRON ROD WITH GEAR ATTACHED.*
△	*CALCULATED POINT.*
R1	*RECORD INFORMATION PER M21-14.*
R2	*RECORD INFORMATION PER M9-62.*
R3	*RECORD INFORMATION PER CS 50/150.*
R4	*RECORD INFORMATION PER M80-16.*
R5	*RECORD INFORMATION PER M22-18.*

CERTIFICATE EXPIRATION DATE: 12-31-95

MAP PREPARED BY

PACIFIC SURVEYING TECHNOLOGY, INC.
P.O. BOX 516
SUTHERLIN, OR 97479
TEL. (503 459-4106)

COUNTY SURVEYORS FILE DATA
DO NOT REMOVE FROM OFFICE

MAP FILE M 118-56